

### LABOR AND MATERIALS

Copper } Connection _____	\$ _____
Lead } _____	\$ _____
Curb } Cook Valve _____ in.	\$ _____
} T. S. & V. } _____	\$ _____
Service box { Short 3½ x 4½ }	\$ _____
Old returned { Long 4½ x 5½ }	
Ft. <sup>3/4</sup> in. { Copper } Pipe at _____	\$ _____
} <del>C.I.</del>	
} <del>C.I.</del>	
Nipples _____ in. at _____	\$ _____
Bushings _____ to _____ in. at _____	\$ _____
Red'g } Coupl'gs _____ to _____ in. at _____	\$ _____
Inc'g } _____	
Union _____ in. at _____	\$ _____
Meter _____ in. at _____	\$ _____
_____	\$ _____
Compound Joints at _____	\$ _____
Maintenance Foreman _____	\$ _____
Hrs. Water Maint. Man—1 at _____	\$ _____
Hrs. Water Maint. Man—2 at _____	\$ _____
Hrs. Garage Foreman _____ at _____	\$ _____
Hrs. Labor— _____ at _____	\$ _____
Hrs. Compressor at _____	\$ _____
_____	\$ _____
Trucking _____	\$ _____
Pav't Patch _____	\$ _____
_____	\$ _____
_____	\$ _____
_____	\$ _____
_____	\$ _____


W. BOYLSTON

St. Pl.  
Ave. No. 6

Name of Owner \_\_\_\_\_

Labor and Mat'l. Report \_\_\_\_\_

1992

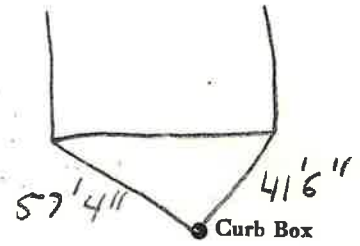

_____ Main	Elev. of Main at tap _____
Gate at ● _____	● Gate at _____

● Curb Box