

LABOR AND MATERIALS


Copper	}	Connection		\$		
Lead						
Curb	}	Cock	in.	\$		
		Valve				
		T. S. & V.				
Service box	}	Short 3 1/2 x 4 1/2				
Old returned		Long 4 1/2 x 5 1/2				
33 1/8 Ft.	3/4 in.	}	Copper	Pipe at	\$	
			G. I.			
			C. I.			
Nipples	in.	at		\$		
Bushings	to	in.	at	\$		
Red'g	}	Coupl'gs	to	in.	at	
Inc'g						
Union	in.	at		\$		
Meter	in.	at		\$		
Compound Joints	at			\$		
Maintenance Foreman				\$		
Hrs. Water Maint. Man—1	at			\$		
Hrs. Water Maint. Man—2	at			\$		
Hrs. Garage Foreman	at			\$		
Hrs. Labor	at			\$		
Hrs. Compressor	at			\$		
Trucking				\$		
Pav't Patch				\$		
				\$		
				\$		
St. 38
 Ave. No. 42

E. BOYLSTON

Name of Owner

Labor and Mat'l. Report 1999

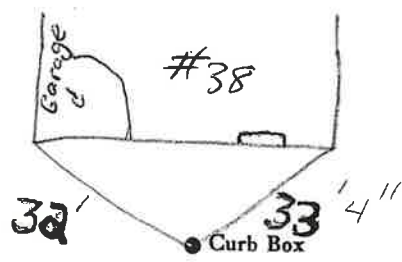

6" Main Elev. of Main at tap _____

Gate at ● ● Gate at

● Curb Box