


LABOR AND MATERIALS

_____	Copper	} Connection	_____	\$	
_____	Lead				
_____	Curb	} Cock Valve T.S. & V.	_____ in.	\$	
_____	Service box		{ Short 3-1/2 x 4-1/2 Long 4-1/2 x 5-1/2 }	_____	\$
_____	Old returned				
45	Ft.	} Copper	_____ in.	Pipe at _____ \$	
3/4	in.				
_____	Nipples	_____ in.	at _____	\$	
_____	Bushings	_____ to _____	in. at _____	\$	
_____	Red'g				
_____	Inc'g				
_____	Union	_____ in.	at _____	\$	
_____	Meter	_____ in.	at _____	\$	
_____				\$	
_____	Compound Joints	at _____		\$	
_____	Maintenance Foreman			\$	
_____	Hrs. Water Maint. Man - 1	at _____		\$	
_____	Hrs. Water Maint. Man - 2	at _____		\$	
_____	Hrs. Garage Foreman	at _____		\$	
_____	Hrs. Labor	at _____		\$	
_____	Hrs. Compressor	at _____		\$	
_____				\$	
_____	Trucking			\$	
_____	Pav't Patch			\$	
_____				\$	
_____				\$	
_____				\$	
_____				\$	

St. BOYLSTON
 Ave. No. 42 E.
 Name of Owner
CLUTE

Labor and Mat'l. Report SEPT. 2000

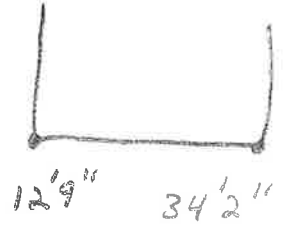

● Curb Box

6" Main Elev. of Main at tap _____
 Gate at ● Gate at ●

● Curb Box

USED EXISTING LOT TAPS