


LABOR AND MATERIALS

Copper } Connection _____	\$ _____
Lead } _____	\$ _____
Curb } Cock _____	\$ _____
} Valve _____	in. _____
} T.S. & V. _____	\$ _____
Service box } Short 3½ x 4½ _____	\$ _____
Old returned } Long 4½ x 5½ _____	\$ _____
18' 2" 3/4 in. } Copper } Pipe at _____	\$ _____
} G.I. _____	
} C.I. _____	
Nipples _____ in. at _____	\$ _____
Bushings _____ to _____ in. at _____	\$ _____
Red'g } Coupl'gs _____ to _____ in. at _____	\$ _____
Inc'g } _____	
Union _____ in. at _____	\$ _____
Meter _____ in. at _____	\$ _____
_____	\$ _____
Compound Joints at _____	\$ _____
Maintenance Foreman _____	\$ _____
Hrs. Water Maint. Man—1 at _____	\$ _____
Hrs. Water Maint. Man—2 at _____	\$ _____
Hrs. Garage Foreman _____ at _____	\$ _____
Hrs. Labor _____ at _____	\$ _____
Hrs. Compressor at _____	\$ _____
_____	\$ _____
Trucking _____	\$ _____
Pav't Patch _____	\$ _____
_____	\$ _____
_____	\$ _____
_____	\$ _____
_____	\$ _____

St. F. BOYKSTON
 Pl. _____
 Ave. No. 43

Name of Owner
H. DELSCHLAGER

Labor and Mat'l. Report 19 96

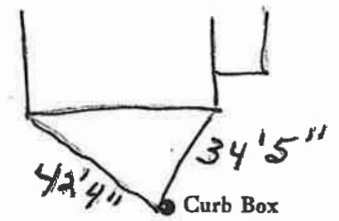

6" Main Elev. of Main at tap _____
 Gate at • • Gate at

TAX ID # 309.16-12-2.2

18' 2" to MAIN • Curb Box
 3/4" Copper