

LABOR AND MATERIALS

_____	Copper } Connection	_____	\$	_____
_____	Lead } Cock	_____	\$	_____
_____	Curb } Valve	_____ in.	\$	_____
_____	_____ } T.S. & V.	_____	\$	_____
_____	Service box { Short 3-1/2 x 4-1/2	_____	\$	_____
_____	Old returned { Long 4-1/2 x 5-1/2	_____	\$	_____
89.7'	Ft. 3/4 in. { Copper	_____	\$	_____
_____	_____ } G.I.	_____	\$	_____
_____	_____ } C.I.	_____	\$	_____
_____	Nipples _____ in. at	_____	\$	_____
_____	Bushings _____ to _____ in. at	_____	\$	_____
_____	Red'g _____	_____	\$	_____
_____	Inc'g _____	_____	\$	_____
_____	Union _____ in. at	_____	\$	_____
_____	Meter _____ in. at	_____	\$	_____
_____	_____	_____	\$	_____
_____	Compound Joints at	_____	\$	_____
_____	Maintenance Foreman _____	_____	\$	_____
_____	Hrs. Water Maint. Man - 1 at	_____	\$	_____
_____	Hrs. Water Maint. Man - 2 at	_____	\$	_____
_____	Hrs. Garage Foreman _____ at	_____	\$	_____
_____	Hrs. Labor _____ at	_____	\$	_____
_____	Hrs. Compressor at	_____	\$	_____
_____	_____	_____	\$	_____
_____	Trucking _____	_____	\$	_____
_____	Pav't Patch _____	_____	\$	_____
_____	_____	_____	\$	_____
_____	_____	_____	\$	_____
_____	_____	_____	\$	_____
_____	_____	_____	\$	_____


BOYLSTON

St. Pl. Ave. No.

69 LOT 17

Name of Owner
TAX ID # 309.15-16-17

Labor and Mat'l. Report 19 DEC. 30, 2003

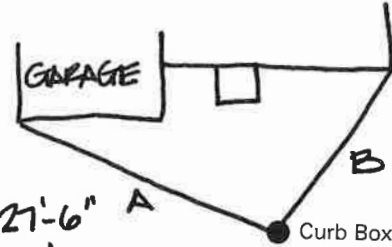


A = 27'-6"
B = 25'

8" Main

Elev. of Main at tap 4.75'

Gate at ●

● Gate at

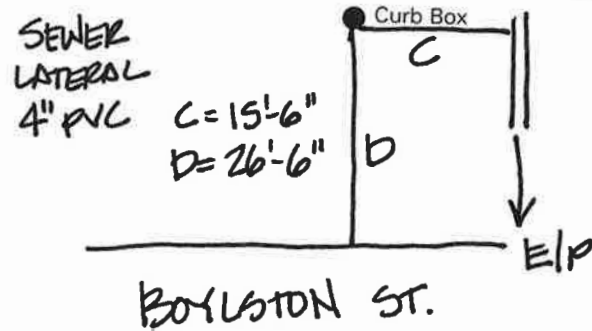

SEWER LATERAL
4" PVC

C = 15'-6"
D = 26'-6"

BOYLSTON ST.