

# LABOR AND MATERIALS


_____	Copper } Connection	_____	\$	_____
_____	Lead } Cock	_____	\$	_____
_____	Curb } Valve	_____ in.	\$	_____
_____	T.S. & V. }	_____	\$	_____
_____	Service box { Short 3-1/2 x 4-1/2	_____	\$	_____
_____	Old returned { Long 4-1/2 x 5-1/2	_____	\$	_____
39	Ft. 4 in. } Copper	Pipe at ?	\$	_____
		{ G.I.		
		{ C.I.		
_____	Nipples _____ in. at _____	_____	\$	_____
_____	Bushings _____ to _____ in. at _____	_____	\$	_____
_____	Red'g _____	_____	\$	_____
_____	Inc'g _____	_____	\$	_____
_____	Union _____ in. at _____	_____	\$	_____
_____	Meter _____ in. at _____	_____	\$	_____
_____	_____	_____	\$	_____
_____	Compound Joints at _____	_____	\$	_____
_____	Maintenance Foreman _____	_____	\$	_____
_____	Hrs. Water Maint. Man - 1 at _____	_____	\$	_____
_____	Hrs. Water Maint. Man - 2 at _____	_____	\$	_____
_____	Hrs. Garage Foreman _____ at _____	_____	\$	_____
_____	Hrs. Labor _____ at _____	_____	\$	_____
_____	Hrs. Compressor at _____	_____	\$	_____
_____	_____	_____	\$	_____
_____	Trucking _____	_____	\$	_____
_____	Pav't Patch _____	_____	\$	_____
_____	_____	_____	\$	_____
_____	_____	_____	\$	_____
1 BROAD ST PLAZA

130 BROAD St. Pt. No. \_\_\_\_\_

Name of Owner BROAD ST. PLAZA

Labor and Mat'l. Report 10/30/2010

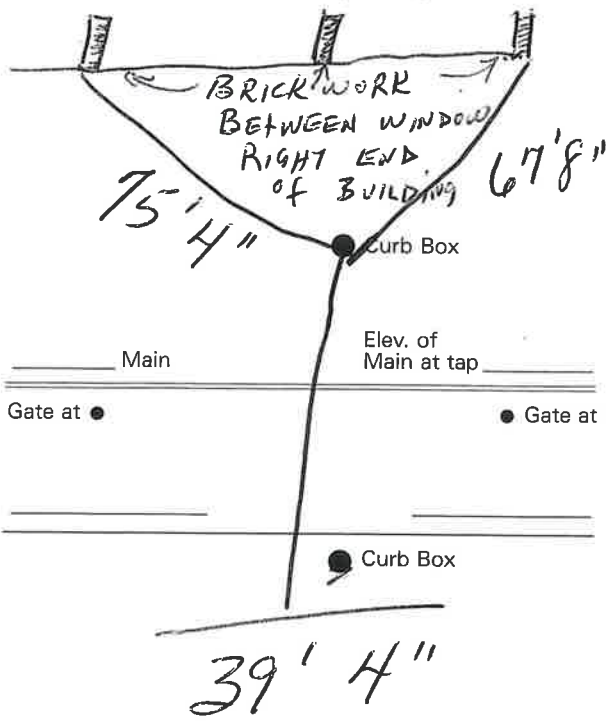

curb box @ curb/ROAD

**Labor and Materials**

Copper } Connection		\$
Lead } Connection		\$
1 Curb } Cook } Valve } T. S. & V. } 6" x 4"		\$ 28.70
1 Service Box } Short 3 1/2 x 4 1/2 Old returned } Long 4 1/2 x 5 1/2 } Buil. or Rdway	Gate box	\$ 5.60
17 Ft. 4" in. } Copper } Galv. Iron } Cast Iron } Pipe at	51¢	\$ 6.12
Nipples	in. at	\$
Bushings	to in. at	\$
Red'g } Couplings	to in. at	\$
Inc'g } Couplings	to in. at	\$
Union	in. at	\$
Meter	in. at	\$
Lbs. Br. Stone	at	\$
Lbs. Sand	at	\$
Bags Cement	at	\$
Paving Brick } Mack } Red } Asphalt } at	1" @ 1.52	\$ 3.04
2 Lead Joints	at 6" x 2 1/4" 4" @ 1.16	\$ 2.32
Leadite Joints	at	\$
13 Hrs. Foreman	at 6 1/2	\$ 8.13
8 Hrs. Common Labor	at Tapper	\$ 4.-
28 Hrs. Common Labor	at 45¢	\$ 12.60
Hrs Mason	at	\$
Hrs Mason's Helper	at	\$
Hrs. Compressor	at	\$
Compensation Ins		\$ .75
Trucking		\$ 2.-
Builders' Use of Water	Patch	\$ 5.-
Total		\$ 78.26

30-202

**Labor and Material Report** Nov 20

1930

169  
New Broad at school

Measure on new Rock

125-137 9  
See GATE BOOK - Page 209  
Broad & Hudson  
Curb Box

6" Main

Elev of Main at tap 4 1/2

Gate at ●

● Gate at

● Curb Box