

LABOR AND MATERIALS

Copper } Connection _____	\$ _____
Lead } _____	
Curb } Cock _____	\$ _____
} Valve _____	in. _____
} T. S. & V. _____	
Service box } Short 3½ x 4½ } _____	\$ _____
Old returned } Long 4½ x 5½ } _____	
Ft. 6" } Copper } Pipe at _____	\$ _____
} G. I. } _____	
} C. I. } _____	
Nipples _____ in. at _____	\$ _____
Bushings _____ to _____ in. at _____	\$ _____
Red'g } Coupl'gs _____ to _____ in. at _____	\$ _____
Inc'g } _____	
Union _____ in. at _____	\$ _____
Meter _____ in. at _____	\$ _____
_____	\$ _____
Compound Joints at _____	\$ _____
Maintenance Foreman _____	\$ _____
Hrs. Water Maint. Man-1 at _____	\$ _____
Hrs. Water Maint. Man-2 at _____	\$ _____
Hrs. Garage Foreman _____ at _____	\$ _____
Hrs. Labor _____ at _____	\$ _____
Hrs. Compressor at _____	\$ _____
_____	\$ _____
Trucking _____	\$ _____
Pav't Patch _____	\$ _____
_____	\$ _____
_____	\$ _____
_____	\$ _____
_____	\$ _____

119 Broad St
 2 Bldgs S Plaza
 Broad St. #


Playa
 -St.
 -Pt.
 Ave. No. 2

Name of Owner

Northcare

Labor and Mat'l. Report

1987

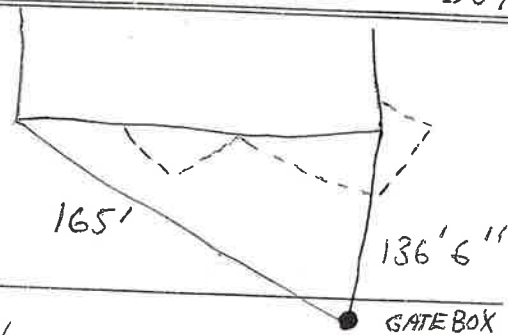

6" Main

Elev. of Main at tap 6'

Gate at ●

● Gate at

● Curb Box