

LABOR AND MATERIALS


Copper	} Connection		\$		
Lead					
Curb	} Cock	} in.	\$		
				} Valve	} T. S. & V.
Service box	} Short 3½ x 4½	} Long 4½ x 5½	\$		
				Old returned	
Ft. 1	} in.	} { Copper	} Pipe at	\$	
					} { G. I.
Nipples	in. at		\$		
Bushings	to	in. at	\$		
Red'g	} Coupl'gs	to	in. at	\$	
Inc'g					
Union	in. at		\$		
Meter	in. at		\$		
			\$		
Compound Joints	at		\$		
Maintenance Foreman			\$		
Hrs. Water Maint. Man—1	at		\$		
Hrs. Water Maint. Man—2	at		\$		
Hrs. Garage Foreman	at		\$		
Hrs. Labor	at		\$		
Hrs. Compressor	at		\$		
			\$		
Trucking			\$		
Pav't Patch			\$		
			\$		
			\$		
			\$		
			\$		

4 BROAD ST. PLAZA

Broad + Mission St.
Pl. Ave. No.

Name of Owner
M. F. National Bank

Labor and Mat'l. Report 19 87

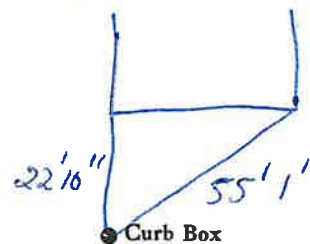

Mission St

Main Elev. of Main at tap Gate at Gate at

Curb Box

Tap on Mission