


LABOR AND MATERIALS

Copper	}	Connection		\$	
Lead					
Curb	}	Cock	} in.	\$	
		Valve			
		T. S. & V.			
Service box	}	Short $3\frac{1}{2} \times 4\frac{1}{2}$	} _____	\$	
		Long $4\frac{1}{2} \times 5\frac{1}{2}$			
Old returned					
Ft. <u>3/4</u> in.	}	Copper	} Pipe at	\$	
		G.I.			
		G.I.			
Nipples	in.	at		\$	
Bushings	to	in.	at	\$	
Red'g	}	Coupl'gs.	to in.	at	\$
Inc'g					
Union	in.	at		\$	
Meter	in.	at		\$	
Compound Joints	at			\$	
Maintenance Foreman				\$	
Hrs. Water Maint. Man	—1	at		\$	
Hrs. Water Maint. Man	—2	at		\$	
Hrs. Garage Foreman		at		\$	
Hrs. Labor		at		\$	
Hrs. Compressor		at		\$	
Trucking				\$	
Pav't Patch				\$	
				\$	
				\$	
				\$	
				\$	

St. Broad
~~Pl.~~
 Ave. No. 1

Name of Owner
F. Colotti

Labor and Mat'l. Report 19

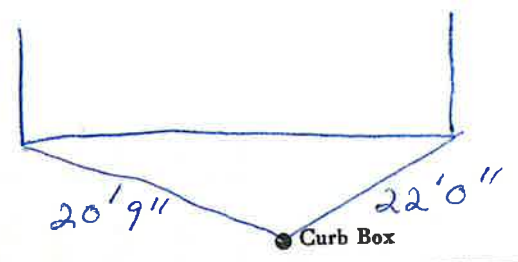

Main Elev. of Main at tap _____

Gate at ● ● Gate at

● Curb Box