
Labor and Materia	ils
Lead Connection	
··· Curb Cock	
Old seturned Long 4 x 5	8.1.44
Ftin. G. I. Pipe at	. 1.37
Nipplesin. at	8
Bushingstoin. at	
······Red'g Coup····to····in. at·······	\$
Ine'g Couptoin. at	\$
Unionin. at	8
Meterin, at	\$
Cu. Yds. Br. Stone at	\$
Cu. Yds. Sand at	\$
Bags Cement at	\$
Paving Brick (Mack Red Asphalt) at	8
2Hrs. Foreman at	. 1.25
	Control of the Contro
Hrs, Mason at	
Hrsat	
Hrsat	\$
Builders' Use of Water	\$
Structe Suo, at	
at	
at	\$
at	8
Total	810.37
	1

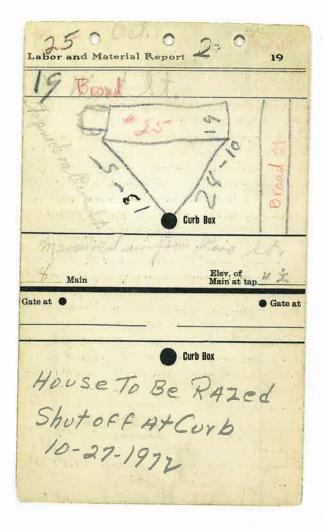

Measured in from Pine Street