


LABOR AND MATERIALS

? Copper	} Connection	_____	\$ _____	
Lead				
? Curb	} Cock Valve T.S. & V.	_____ in.	\$ _____	
1 Service box		} Short 3 1/2 x 4 1/2 } ?		
Old returned	Long 4 1/2 x 5 1/2 } ?		\$ _____	
	Buff or Rdway			
_____ Ft. _____ in.	} Copper } Pipe at _____		\$ _____	
		G. I. }		
		C. I. }		
_____ Nipples _____ in.	at _____		\$ _____	
_____ Bushings _____ to _____ in.	at _____		\$ _____	
_____ Red'g } Coupl'gs _____ to _____ in.	at _____		\$ _____	
_____ Inc'g }				
_____ Union _____ in.	at _____		\$ _____	
_____ Meter _____ in.	at _____		\$ _____	
_____ Lead Joints	at _____		\$ _____	
_____ Compound Joints	at _____		\$ _____	
_____ Maintenance Foreman			\$ _____	
_____ Hrs. Water Maint. Man—1	at _____		\$ _____	
_____ Hrs. Water Maint. Man—2	at _____		\$ _____	
_____ Hrs. Garage Foreman _____	at _____		\$ _____	
_____ Hrs. Labor _____	at _____		\$ _____	
_____ Hrs. Compressor	at _____		\$ _____	
_____ Compensation Ins. at \$ _____	per C _____		\$ _____	
_____ Trucking			\$ _____	
_____ Pay't Patch			\$ _____	
<i>Measured in 7-5-55</i>				
<i>by Miller & Co.</i>				
_____ O'head			\$ _____	

St. Broad
 Pt. 187
 Ave. No. 187

Name of Owner
ZIMMERMAN

Labor and Mat'l. Report ? 19

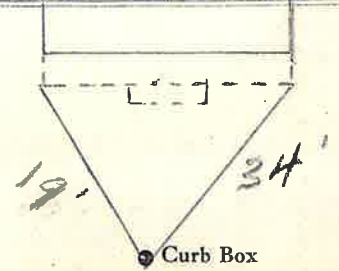

? Main Elev. of Main at tap ?
 Gate at • Gate at

• Curb Box