

Labor and Materials


✓	Copper	} Connection. $\frac{3}{4}$ in	1.48	
✓	Lead			
✓	Curb	} Cock Valve T.S.&V. } $\frac{3}{4}$ in	1.79	
✓	Service Box		} Short $3\frac{1}{2} \times 4\frac{1}{2}$ } Long $4\frac{1}{2} \times 5\frac{1}{2}$ }	1.30
	Old returned	} Buff. or Rawer }		
31	Ft. $\frac{3}{4}$ in.	} Copper Galv. Iron } Cast Iron }	5.58	
	Nipples		in. at	
	Bushings	to in. at		
	Red'g Inc'g	} Couplings	to in. at	
	Union		in. at	
	Meter	in. at		
	Lbs. Br. Stone	at		
	Lbs. Sand	at		
	Bags Cement	at		
	Paving Brick	} Mack Red Asphalt }	at	
	Lead Joints		at	
	Leadite Joints		at	
6	Hrs. Foreman	at	3.75	
4	Hrs. Common Labor	at Tapper	2.00	
4	Hrs. Common Labor	at 40	1.60	
	Hrs. Mason	at		
	Hrs. Masons Helper	at		
	Hrs. Compressor	at		
	Compensation Ins		23	
	Trucking		1.00	
	Builders Use of Water	Patch	2.50	
Total			21.23	

532-138

Labor and Material Report

Nov 15 1922

154 Broad St

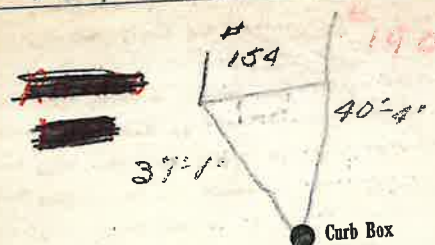

6" Main

Elev. of Main at tap 5'

Gate at ●

● Gate at

● Curb Box

New Tap Water + Sewer
old House

OK 11/14