


LABOR AND MATERIALS

Copper	} Connection	_____	\$ _____
Lead			
Curb	} Cock Valve T. S. & V. }	_____ in.	\$ _____
Service box	{ Short 3 1/2 x 4 1/2 } Long 4 1/2 x 5 1/2 }	_____	\$ _____
Old returned			
Ft. <u>4</u> in.	{ Copper } G. I. } Pipe at	_____	\$ _____
Nipples	_____ in. at	\$ _____	
Bushings	_____ to _____ in. at	\$ _____	
Red'g Inc'g	} Coupl'gs _____ to _____ in. at	\$ _____	
Union		_____ in. at	\$ _____
Meter	_____ in. at	\$ _____	
		\$ _____	
Compound Joints	at	\$ _____	
Maintenance Foreman		\$ _____	
Hrs. Water Maint. Man	—1 at	\$ _____	
Hrs. Water Maint. Man	—2 at	\$ _____	
Hrs. Garage Foreman	_____ at	\$ _____	
Hrs. Labor	_____ at	\$ _____	
Hrs. Compressor	at	\$ _____	
		\$ _____	
Trucking		\$ _____	
Pav't Patch		\$ _____	
		\$ _____	
		\$ _____	
		\$ _____	
		\$ _____	

St. Brook
Pt. _____
Ave. No. 194

Name of Owner
Stephen Vamvalie

Labor and Mat'l. Report 6 1985

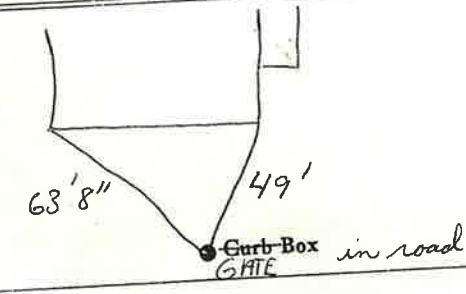

Main _____ Elev. of Main at tap _____
Gate at ● _____ Gate at ● _____
● Curb Box