

LABOR AND MATERIALS


1	Copper	}	Connection	1"	\$		
	Lead						
1	Curb	}	Cock	1 in.	\$		
				Valve			
			T. S. & V.				
1	Service box	}	Short $3\frac{1}{2} \times 4\frac{1}{2}$				
	Old returned			Long $4\frac{1}{2} \times 5\frac{1}{2}$			
				Buff or Rdway			
40	Ft. 1 in.	}	Copper	Pipe at	\$		
				G. I.			
				C. I.			
	Nipples		in. at		\$		
1	Bushings		to	Male Adapter	\$		
	Red'g	}	Coupl'gs	to	in. at	\$	
	Inc'g						
	Union		in. at		\$		
	Meter		in. at		\$		
	Lead Joints		at		\$		
	Compound Joints		at		\$		
	Maintenance Foreman				\$		
	Hrs. Water Maint. Man		1 at		\$		
	Hrs. Water Maint. Man		2 at		\$		
	Hrs. Garage Foreman		at		\$		
	Hrs. Labor		at		\$		
	Hrs. Compressor		at		\$		
	Compensation Ins. at \$		per C		\$		
	Trucking				\$		
	Pav't Patch				\$		
	Tap by Gifford & Co.				\$		
	3-22-68.				\$		
	O'head				\$		

1-Curb stop 10' from main.

St. Broad
Pl. 194
Ave, No. 194

Name of Owner
Demetrius Vamvalis

Labor and Mat'l. Report Mar 22 1968

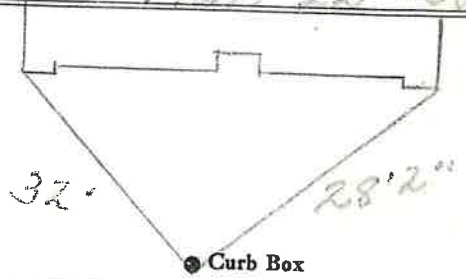

6" Main Elev. of Main at tap 6'

Gate at ● ● Gate at

● Curb Box


LABOR AND MATERIALS

_____ Copper } Connection _____ \$ _____
 _____ Lead }
 _____ Curb } Cock } _____ in. _____ \$ _____
 _____ Valve }
 _____ T.S. & V. }
 _____ Service box { Short 3-1/2 x 4-1/2 } _____ \$ _____
 _____ Old returned { Long 4-1/2 x 5-1/2 }
 _____ Ft. _____ in. { Copper } Pipe at _____ \$ _____
 _____ G.I.
 _____ C.I.
 _____ Nipples _____ in. at _____ \$ _____
 _____ Bushings _____ to _____ in. at _____ \$ _____
 _____ Red'g _____
 _____ Inc'g _____
 _____ Union _____ in. at _____ \$ _____
 _____ Meter _____ in. at _____ \$ _____
 _____ \$ _____
 _____ Compound Joints at _____ \$ _____
 _____ Maintenance Foreman _____ \$ _____
 _____ Hrs. Water Maint. Man - 1 at _____ \$ _____
 _____ Hrs. Water Maint. Man - 2 at _____ \$ _____
 _____ Hrs. Garage Foreman _____ at _____ \$ _____
 _____ Hrs. Labor _____ at _____ \$ _____
 _____ Hrs. Compressor at _____ \$ _____
 _____ \$ _____
 _____ Trucking _____ \$ _____
 _____ Pav't Patch _____ \$ _____
 _____ \$ _____
 _____ \$ _____
Steve's Place St. Broad St
 Pl. Ave. No. 194

Name of Owner _____

Labor and Mat'l. Report 1/15/13

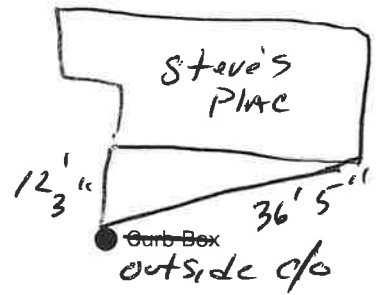

_____ Main Elev. of Main at tap _____

Gate at ● Gate at ●

● Curb Box