


### LABOR AND MATERIALS

1	Copper Lead	Connection	1 1/4" or 1 seal.	\$
1	Curb	Cock Valve T.S. & V.	1 1/4 in.	\$
1	Service box	Short 3 1/2 x 4 1/2	or 1 seal.	
	Old returned	Long 4 1/2 x 5 1/2	Curb box	
		Buff or Rdway		\$
40	Ft.	1 1/4 in.	Copper G.I. C.I. Pipe at	\$
	Nipples	in. at		\$
	Bushings	to in. at		\$
	Red'g Inc'g	Coupl'gs to in. at		\$
	Union	in. at		\$
1	Meter	1 1/4 in. at	Worthimato	\$
	Lead Joints	at	Watch Pipe	\$
	Compound Joints	at		\$
	Maintenance Foreman			\$
	Hrs. Water Maint. Man	1 at		\$
	Hrs. Water Maint. Man	2 at		\$
	Hrs. Garage Foreman	at		\$
	Hrs. Labor	at		\$
	Hrs. Compressor	at		\$
	Compensation Ins.	at \$ per C		\$
	Trucking			\$
	Pav't Patch			\$
			107 by Gifford & Co.	\$
			4-28-66.	\$
	O'head			\$

St. Pl. Ave. No. 198

Name of Owner  
Demetrius Tomvalis

Labor and Mat'l. Report April 28 19 66

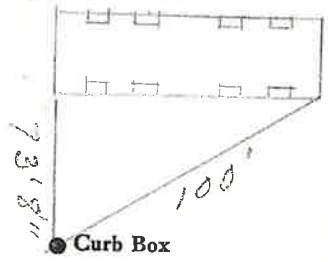

6" Main Elev. of Main at tap 5 1/2

Gate at ● ● Gate at

● Curb Box

Car Wash,  
This Tap on  
Broad St.