

LABOR AND MATERIALS

|    |                          |  |            |    |
|----|--------------------------|--|------------|----|
| 1  | Copper Lead              | Connection   | 1 1/4"     | \$ |
| 1  | Curb                     | Cock Valve T. S. & V.                                      | 1 1/4" in. | \$ |
| 1  | Service box Old returned | Short 3 1/2 x 4 1/2<br>Long 4 1/2 x 5 1/2<br>Buff or Rdway |            | \$ |
| 38 | Ft. 1 1/4 in.            | Copper<br>C.I.<br>C.I.                                     | Pipe at    | \$ |
|    | Nipples                  | in. at   |            | \$ |
|    | Bushings                 | to in. at  |            | \$ |
|    | Red'g<br>Inc'g           | Coupl'gs   | to in. at  | \$ |
|    | Union                    | in. at   |            | \$ |
|    | Meter                    | in. at   |            | \$ |
|    | Lead Joints              | at   |            | \$ |
|    | Compound Joints          | at   |            | \$ |
|    | Maintenance Foreman      |  |            | \$ |
|    | Hrs. Water Maint. Man-1  | at   |            | \$ |
|    | Hrs. Water Maint. Man-2  | at   |            | \$ |
|    | Hrs. Garage Foreman      | at   |            | \$ |
|    | Hrs. Labor               | at   |            | \$ |
|    | Hrs. Compressor          | at   |            | \$ |
|    | Compensation Ins.        | at \$ per C  |            | \$ |
|    | Trucking                 |  |            | \$ |
|    | Pav't Patch              |  |            | \$ |
|    | Tap by G. I. SSOIRD      |  |            | \$ |
|    | 4 Co. 5-14-59            |  |            | \$ |
|    | O'head                   |  |            | \$ |

St. Broad Pl. 200  
Ave. No. 200

Name of Owner  
(Laundry) Burnham

Labor and Mat'l. Report May 14. 19 59

30' 4" **RAZED** 32'

● Curb Box

6" Main Elev. of Main at tap 5 1/2

Gate at ● Gate at ●

● Curb Box

old Tap 1 1/4"  
This Tap is shut off  
At CURB

LSM 2550


LABOR AND MATERIALS

1 Copper } Connection 1 1/4" \$  
 Lead }  
 1 Curb } Cock } 2 in. \$  
           } Valve }  
           } T.S. & V. }  
 1 Service box { Short 3 1/2 x 4 1/2 } 5' oriseal.  
 Old returned { Long 4 1/2 x 5 1/2 }  
                   { Buff or Rdway } \$  
 36 Ft. 2 in. { Copper } Pipe at \$  
                   { G.I. }  
                   { G.I. }  
 Nipples in. at \$  
 1 Bushings 2 to 1 1/2 in. at \$  
 Red'g }  
 1 Inc'g } Coupl'gs 2" to 3 Pieces \$  
 1 Union 2 in. at Brass Elbow \$  
 Meter in. at \$  
 Lead Joints at \$  
 Compound Joints at \$  
 Maintenance Foreman \$  
 Hrs. Water Maint. Man-1 at \$  
 Hrs. Water Maint. Man-2 at \$  
 Hrs. Garage Foreman at \$  
 Hrs. Labor- at \$  
 Hrs. Compressor at \$  
 Compensation Ins. at \$ per C \$  
 Trucking \$  
 Pav't Patch \$  
 Tap by Gifford \$ 2.00  
 O'head \$  
 \$

Broad St. Pl. Ave. No. 200

Name of Owner D. Vamvakalis

Labor and Mat'l. Report April 1969

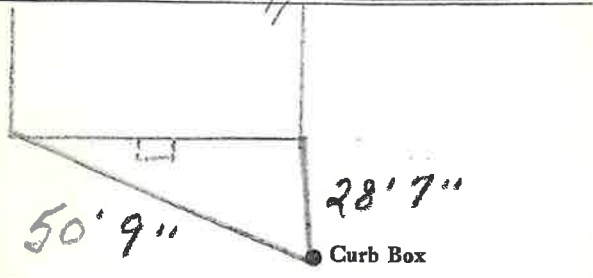

6" Main Elev. of Main at tap 5'

Gate at • Gate at •

• Curb Box