

LABOR AND MATERIALS

1	Copper	Connection	1 1/2"	\$	12.37
1	Lead	Cock	1 1/2 in.	\$	13.45
1	Curb	Valve			
		T.S. & V.			
1	Service box	Short 3 1/2 x 4 1/2			
	Old returned	Long 4 1/2 x 5 1/2			11.20?
		Buff or Rdway			
20	Ft. 1 1/2 in.	Copper	Pipe at	90	\$ 16.00
		G.I.			
		G.I.			
	Nipples	in. at		\$	
	Bushings	to in. at		\$	
	Red'g				
	Inc'g	Coupl'gs	to in. at	\$	
	Union	in. at		\$	
	Meter	in. at		\$	
	Lead Joints	at		\$	
	Compound Joints	at		\$	
5 1/2	Maintenance Foreman	1.937		\$	10.65
	Hrs. Water Maint. Man-1	at		\$	
	Hrs. Water Maint. Man-2	at		\$	
2	Hrs. Garage Foreman	at 2.033		\$	4.07
10	Hrs. Labor	at 1.30		\$	13.00
	Hrs. Compressor	at		\$	
	Compensation Ins.	at \$ 5.686 per C		\$	
	Trucking			\$	1.50
	Pay't Patch			\$	
	Tap by Wadleigh, Lareau			\$	
	+ Cb. 6-11-56.			\$	
	O'head			\$	

St.   
 Pl.   
 Ave. No. 31

Broad

Name of Owner   
 St. Alphonsus Church.

Labor and Mat'l. Report June 11 1956

Curb Box gate

Crandall St.

Elev. of Main at tap

Gate at • Gate at

• Curb Box

1 1/2" Tap ON   
 Crandall St.

L M-5C-2-1-54


LABOR AND MATERIALS

1	Copper	} Connection 1"	\$ 4.25
	Lead		
1	Curb	} 1 in.	\$ 5.25
	Cock		
	Valve T.S. & V.		
1	Service box	} Short 3 1/2 x 4 1/2	\$ 4.69
	Old returned		
		} Long 4 1/2 x 5 1/2	
		} Buff or Rdway	
8	Ft. 1 in.	} Pipe at 56	\$ 11.48
		} Copper	
		} G.I.	
		} C.I.	
	Nipples	in. at	\$
	Bushings	to in. at	\$
	Red'g		
	Inc'g	Coupl'gs to in. at	\$
	Union	in. at	\$
	Meter	in. at	\$
	Lead Joints	at	\$
	Compound Joints	at	\$
	Maintenance Foreman		\$
	Hrs. Water Maint. Man	1 at	\$
8	Hrs. Water Maint. Man	2 at	\$ 12.90
	Hrs. Garage Foreman	at	\$
16	Hrs. Labor	at 1.30	\$ 20.80
	Hrs. Compressor	at	\$
	Compensation Ins.	at \$ 5.686 per C	\$ 1.92
	Trucking		\$ 1.50
	Pav't Patch		\$ 4.85
	Tap by Gifford		\$
		5-25-56	\$
			\$
	O'head		\$
			\$ 70.67

Broad St. Pl. Ave. No. 31433

Name of Owner  
St. Alphonsus Church

Labor and Mat'l. Report May 25 19 56

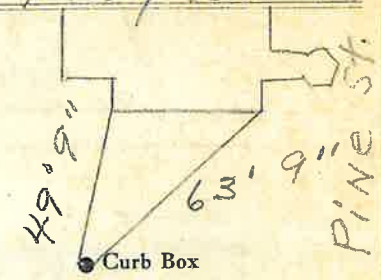

Broad St.  
6" Main Elev. of Main at tap 5 1/2"

Gate at • Gate at

• Curb Box