


# LABOR AND MATERIALS

_____	Copper } Connection _____	\$ _____
_____	Lead } _____	\$ _____
_____	Curb } Cock _____	\$ _____
_____	Valve } _____ in.	\$ _____
_____	T.S. & V. } _____	\$ _____
_____	Service box { Short 3-1/2 x 4-1/2 }	\$ _____
_____	Old returned { Long 4-1/2 x 5-1/2 }	\$ _____
10	Ft. 4 in. { Copper } Pipe at _____	\$ _____
_____	{ C.I. } _____	\$ _____
_____	Nipples _____ in. at _____	\$ _____
_____	Bushings _____ to _____ in. at _____	\$ _____
_____	Red'g _____	\$ _____
_____	Inc'g _____	\$ _____
_____	Union _____ in. at _____	\$ _____
_____	Meter _____ in. at _____	\$ _____
_____	_____	\$ _____
_____	Compound Joints at _____	\$ _____
_____	Maintenance Foreman _____	\$ _____
_____	Hrs. Water Maint. Man - 1 at _____	\$ _____
_____	Hrs. Water Maint. Man - 2 at _____	\$ _____
_____	Hrs. Garage Foreman _____ at _____	\$ _____
_____	Hrs. Labor _____ at _____	\$ _____
_____	Hrs. Compressor at _____	\$ _____
_____	_____	\$ _____
_____	Trucking _____	\$ _____
_____	Pav't Patch _____	\$ _____
_____	_____	\$ _____
_____	_____	\$ _____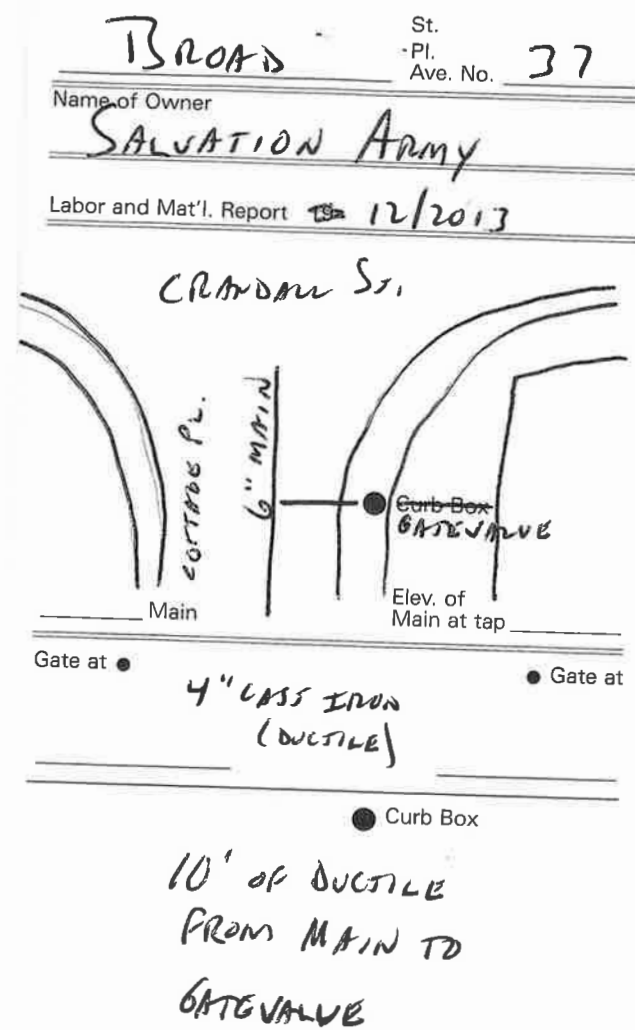
TAX ID # 309.27-7-3


LABOR AND MATERIALS

1	Copper Lead	Connection	$\frac{3}{4}$	\$	_____
1	Curb	Cock Valve	$\frac{3}{4}$ in.	\$	_____
		T.S. & V.			
1	Service box	Short	$3\frac{1}{2} \times 4\frac{1}{2}$		
	Old returned	Long	$4\frac{1}{2} \times 5\frac{1}{2}$	\$	_____
8	Ft.	$\frac{3}{4}$ in.	Copper Pipe	\$	_____
			at		
	Nipples	in.	at	\$	_____
	Bushings	to	in.	at	\$
	Red'g				
	Inc'g	Coupl'gs	to	in.	at
	Union	in.	at	\$	_____
	Meter	in.	at	\$	_____
				\$	_____
	Compound Joints	at		\$	_____
	Maintenance Foreman			\$	_____
	Hrs. Water Maint. Man	—1	at	\$	_____
	Hrs. Water Maint. Man	—2	at	\$	_____
	Hrs. Garage Foreman		at	\$	_____
	Hrs. Labor		at	\$	_____
	Hrs. Compressor	at		\$	_____
				\$	_____
	Trucking			\$	_____
	Pav't Patch			\$	_____
				\$	_____
				\$	_____
				\$	_____
				\$	_____

BROAD St. Pl. Ave. No. 35-37

Name of Owner \_\_\_\_\_

Labor and Mat'l. Report SEPT. 19 35

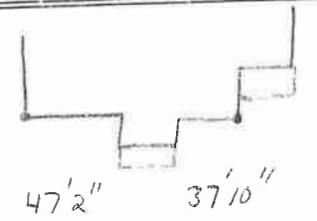

● Curb Box

6" Main Elev. of Main at tap  $5\frac{1}{2}'$

Gate at ● Gate at ●

● Curb Box

OLD TAP SHUT OFF

LSM-5C-6-1-67