


LABOR AND MATERIALS

Copper	} Connection	_____	\$ _____	
Lead				
Curb	} Cock Valve T. S. & V. }	_____ in.	\$ _____	
		} Short 3 1/2 x 4 1/2 }		
			Long 4 1/2 x 5 1/2 }	
Service box		_____	\$ _____	
Old returned		_____	\$ _____	
116" Ft. 3/4 in.	} Copper G.I. C.I. }	Pipe at _____	\$ _____	
Nipples _____ in. at _____			\$ _____	
Bushings _____ to _____ in. at _____			\$ _____	
Red'g } Inc'g }	} Coupl'gs	_____ to _____ in. at _____	\$ _____	
Union _____ in. at _____			\$ _____	
Meter _____ in. at _____		\$ _____		
_____		\$ _____		
Compound Joints at _____		\$ _____		
Maintenance Foreman _____		\$ _____		
Hrs. Water Maint. Man-1 at _____		\$ _____		
Hrs. Water Maint. Man-2 at _____		\$ _____		
Hrs. Garage Foreman _____ at _____		\$ _____		
Hrs. Labor _____ at _____		\$ _____		
Hrs. Compressor at _____		\$ _____		
_____		\$ _____		
Trucking _____		\$ _____		
Pav't Patch _____		\$ _____		
_____		\$ _____		
_____		\$ _____		
_____		\$ _____		
_____		\$ _____		

BROAD St.
Pt. Ave. No. 49AB

Name of Owner
SULLY'S BAR.

Labor and Mat'l. Report 19 99

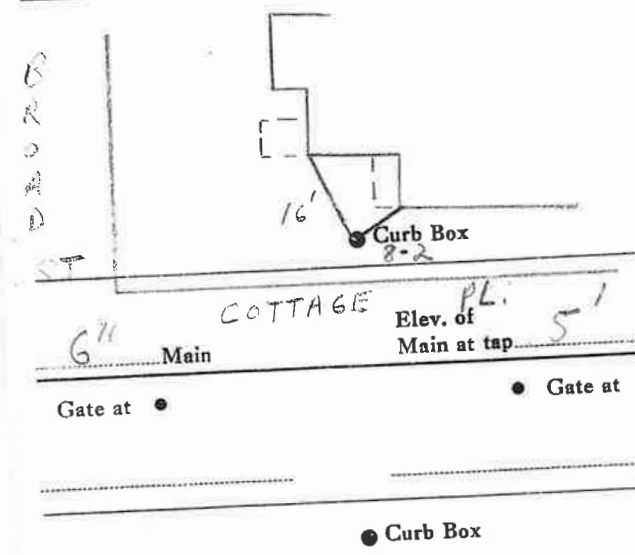

TAX ID # 309.27-6-15