


LABOR AND MATERIALS

1	Copper	Connection } $\frac{3}{4}$ "	\$
1	Lead		
1	Curb	Cock Valve } $\frac{3}{4}$ in. Oriseal	\$
			T. S. & V.
1	Service box	Short $3\frac{1}{2}$ x $4\frac{1}{2}$ Long $4\frac{1}{2}$ x $5\frac{1}{2}$ Buff or Rdway	\$
	Old returned		
7	$\frac{3}{4}$ in.	Copper } Pipe at	\$
			G. I.
		C. I.	\$
	Nipples	in. at	\$
	Bushings	to in. at	\$
	Red'g	Coupl'gs to in. at	\$
	Inc'g		
	Union	in. at	\$
	Meter	in. at	\$
	Lead Joints	at	\$
	Compound Joints	at	\$
	Maintenance Foreman		\$
	Hrs. Water Maint. Man	1 at	\$
	Hrs. Water Maint. Man	2 at	\$
	Hrs. Garage Foreman	at	\$
	Hrs. Labor	at	\$
	Hrs. Compressor	at	\$
	Compensation Ins.	at \$ per C	\$
	Trucking		\$
	Pav't Patch		\$
	Tap by Giggard & Co.		\$
		6-13-63	\$
	O'head		\$
			\$

St. Broad Pl. 51
Ave. No. 51
Name of Owner William McGarr

Labor and Mat'l. Report June 13 19 63

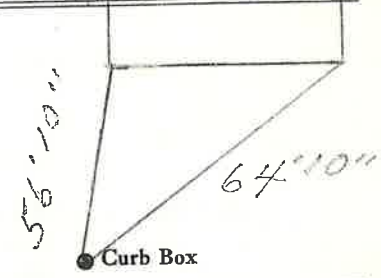

6" C.I. Main Elev. of Main at tap 5 1/2'
Gate at ● Gate at ●

● Curb Box