


Labor and Materials


Copper } Connection.....	3	96
Lead }		
Curb { Cock }	1	33
{ Valve }		
{ P.S. & V. }		
Service Box { Short 3 1/2 x 4 1/2 }	1	35
Old returned { Long 4 1/2 x 5 1/2 }		
{ Buff. or Rdwdr. }		
42 Ft. 2 1/4 in. { Copper } Pipe at 15		630
{ Galv. Iron }		
{ Cast Iron }		
Nipples		
Bushings		
Red'g } Couplings.....		
Ino'g }		
Union.....		
Meter.....		
Lbs. Br. Stone at		
Lbs. Sand at		
Bags Cement at		
Paving Brick { Mack } at		
{ Red }		
{ Asphalt }		
Lead Joints at		
Leadite Joints at		
Hrs. Foreman at		
Hrs. Common Labor at		
Hrs. Mason at		
Hrs. Masons Helper at		
Hrs. Compressor at		
Compensation Ins		
Trucking		
Builders Use of Water Patch		5
Total \$.....		

37-36 54
 Labor and Material Report
 22, 19 14

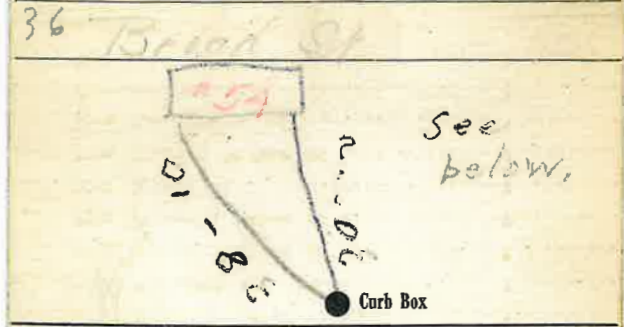

6 Main Elev. of Main at tap 5

Gate at ● Gate at ●

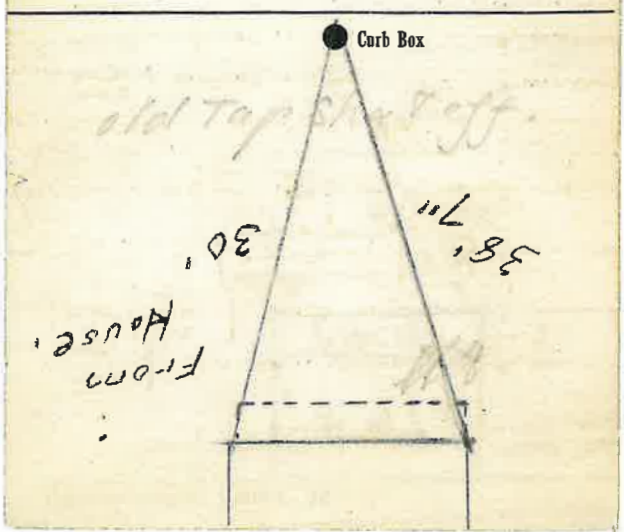

ALL HOUSES RAZED