


LABOR AND MATERIALS

1	Copper Lead	Connection	$\frac{3}{4}$ "	\$
1	Curb	Cock Valve T.S. & V.	in.	\$
1	Service box	Short $3\frac{1}{2}$ x $4\frac{1}{2}$		
	Old returned	Long $4\frac{1}{2}$ x $5\frac{1}{2}$		\$
9	Ft.	$\frac{3}{4}$ in. Copper G.I. C.I.	Pipe at	\$
	Nipples	in. at		\$
	Bushings	to in. at		\$
	Red'g Inc'g	Coupl'gs to in. at		\$
	Union	in. at		\$
	Meter	in. at		\$
	Compound Joints	at		\$
	Maintenance Foreman			\$
	Hrs. Water Maint. Man-1	at		\$
	Hrs. Water Maint. Man-2	at		\$
	Hrs. Garage Foreman	at		\$
	Hrs. Labor	at		\$
	Hrs. Compressor	at		\$
	Trucking			\$
	Pav't Patch			\$
				\$
				\$
BROAD St. Pl. Ave. No. 55

Name of Owner

Labor and Mat'l. Report JULY 1934

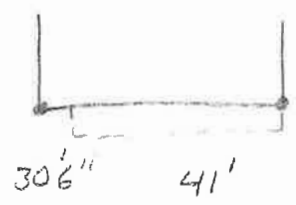

● Curb Box

Main Elev. of Main at tap 5 1/2'

Gate at ● Gate at

● Curb Box

OLD TAP DISCONNECTED

TAX ID # 309.27-7-3