

LABOR AND MATERIALS

| | | | |
|---|-------------------------|------------------------------|--------------------|
| 1 | Copper | } Connection ^{3/4"} | \$ |
| | Lead | | |
| 1 | Curb | } 1" in. | \$ |
| | Cock | | |
| | Valve | | |
| | T.S. & W. | | |
| 1 | Service box | } Short 3 1/2 x 4 1/2 | \$ |
| | Old returned | | Long 4 1/2 x 5 1/2 |
| 5 | Ft. 1" in. | } Copper | \$ |
| | | | G. I. |
| | | | C.I. |
| | | } Pipe at | \$ |
| | Nipples | in. at | \$ |
| | Bushings | to in. at | \$ |
| | Red'g | } Coupl'gs to in. at | \$ |
| | Inc'g | | |
| | Union | in. at | \$ |
| | Meter | in. at | \$ |
| | | | \$ |
| | Compound Joints | at | \$ |
| | Maintenance Foreman | | \$ |
| | Hrs. Water Maint. Man—1 | at | \$ |
| | Hrs. Water Maint. Man—2 | at | \$ |
| | Hrs. Garage Foreman | at | \$ |
| | Hrs. Labor— | at | \$ |
| | Hrs. Compressor | at | \$ |
| | | | \$ |
| | Trucking | | \$ |
| | Pav't Patch | | \$ |
| | | | \$ |
| | | | \$ |
| | | | \$ |
| | | | \$ |


BROAD

St. Pt. Ave. No. 57

Name of Owner

Labor and Mat'l. Report

JULY 1924

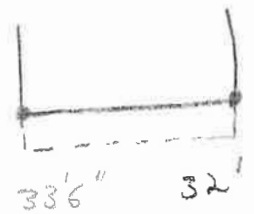

● Curb Box

6" Main

Elev. of Main at tap 4 1/2'

Gate at ●

● Gate at

● Curb Box

TAX ID # 309.27-6-12


LABOR AND MATERIALS

Copper } Connection _____ \$
 Lead }
 Curb } Cock Valve } _____ in. \$
 T.S. & V. }
 Service box { Short 3-1/2 x 4-1/2 } _____ \$
 Old returned { Long 4-1/2 x 5-1/2 }
 Ft. _____ in. { Copper } Pipe at _____ \$
 G.I.
 C.I.
 Nipples _____ in. at _____ \$
 Bushings _____ to _____ in. at _____ \$
 Red'g _____
 Inc'g _____
 Union _____ in. at _____ \$
 Meter _____ in. at _____ \$
 _____ \$
 Compound Joints at _____ \$
 Maintenance Foreman _____ \$
 Hrs. Water Maint. Man - 1 at _____ \$
 Hrs. Water Maint. Man - 2 at _____ \$
 Hrs. Garage Foreman _____ at _____ \$
 Hrs. Labor _____ at _____ \$
 Hrs. Compressor at _____ \$
 _____ \$
 Trucking _____ \$
 Pav't Patch _____ \$
 _____ \$
 _____ \$
 _____ \$
 _____ \$

Broad St. Ave. No. 57

Name of Owner _____

Labor and Mat'l. Report 19 _____

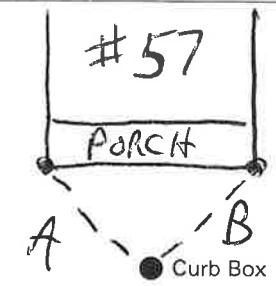

_____ Main Elev. of Main at tap _____

Gate at ● ● Gate at

_____ ● Curb Box

A = 26' 8"
 B = 25'