

LABOR AND MATERIALS

1 Copper { Connection 2" \$20.94  
 Lead }  
 1 Curb { Cock Valve } 2 in. \$19.04  
 T.S. & V. }  
 1 Service box { Short 3 1/2 x 4 1/2 } Small Roadway Gate  
 Old returned { Long 4 1/2 x 5 1/2 } \$11.15 Box  
 Buff or Rdway }  
 9 Ft. 2 in. { Copper } Pipe at 116 \$10.44  
 G.I. }  
 C.I. }

Nipples in. at \$  
 Bushings to in. at \$  
 Red'g { Coupl'gs to in. at \$  
 Inc'g }  
 Union in. at \$  
 Meter in. at \$  
 Lead Joints at \$  
 11 Compound Joints at Maint Form 133 \$14.67  
 8 Hrs. Water Maint. Man-1 at 1.23 \$9.84  
 2 Hrs. Water Maint. Man-2 at 1.13 \$2.26  
 40 Hrs. Labor at 1.02 \$40.80  
 Hrs. Labor at \$  
 Hrs. Compressor at \$  
 Compensation Ins. at \$3.706 per C. \$2.76  
 Trucking \$1.00  
 Pav't Patch \$20.16  
 O'head \$

Tap by Warsinski \$159.74  
 + Gifford  
 1-31-52

Broad


St. PL. 5  
 Ave. No.

Name of Owner

FRANK COLLOTTI

Labor and Mat'l. Report

JAN. 30, 1952

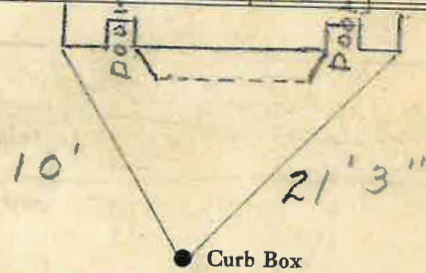

● Curb Box

6" Main

Elev. of Main at tap 5 1/2'

Gate at ●

● Gate at

● Curb Box

TAX ID # 309.28-1-5