


Labor and Materials

1	Copper	Connection	3/4	\$	3.20
1	Lead	Cock Valve	3/4 in.	\$	1.00
1	Curb	T.S. & V.		\$	
1	Service Box	Short 3 1/2 x 4 1/2		\$	1.30
	Old returned	Long 4 1/2 x 5 1/2		\$	
		Buff. or Rdway		\$	
26	Ft.	Copper	Pipe at	\$	7.92
		Galy. Iron		\$	
		Cast Iron		\$	
	Nipples		in. at	\$	
1	Bushings	3/4 to 1/2	in. at	\$.08
1	Redg. Lock	Couplings	1/2 to 1/4	\$.15
	Union		in. at	\$	
	Meter		in. at	\$	
	Lbs. Br. Stone		at	\$	
	Lbs. Sand		at	\$	
	Bags Cement		at	\$	
	Paving Brick	Mack Red Asphalt	at	\$	
	Lead Joints		at	\$	
	Leadite Joints		at	\$	
2	Hrs. Foreman		at	\$	1.25
7	Hrs. Common Labor		at	\$	3.50
8	Hrs. Common Labor		at	\$	3.24
	Hrs. Mason		at	\$	3.25
	Hrs. Mason's Helper		at	\$	
	Hrs. Compressor		at	\$	
	Compensation Ins.		at	\$	2.7
	Trucking		at	\$	1.00
	Builders' Use of Water		at	\$	
				Total	\$ 22.87

Labor and Material Report

July 27 1922

on H6 Broad St

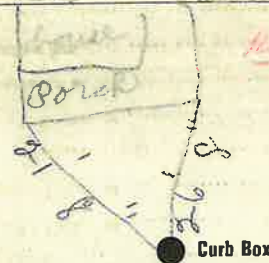

6" Main

Elev. of Main at tap 5'

Gate at ●

● Gate at

● Curb Box