

LABOR AND MATERIALS

1	Copper Lead	} Connection <sup>3/4"</sup>	\$
1	Curb		} Cock Valve T.S. & V. } <sup>3/4"</sup> in.
1	Service box Old returned	} Short 3 1/2 x 4 1/2 Long 4 1/2 x 5 1/2 }	
10	Ft. <sup>3/4"</sup> in.		} Copper C.I. C.I.
	Nipples	in. at \$	
	Bushings	to in. at \$	
	Red'g Inc'g	} Coupl'gs to in. at \$	
	Union		in. at \$
	Meter	in. at \$	
		\$	
	Compound Joints	at \$	
	Maintenance Foreman	\$	
	Hrs. Water Maint. Man—1	at \$	
	Hrs. Water Maint. Man—2	at \$	
	Hrs. Garage Foreman	at \$	
	Hrs. Labor—	at \$	
	Hrs. Compressor	at \$	
		\$	
	Trucking	\$	
	Pav't Patch	\$	
		\$	
		\$	
		\$	
		\$	


BROAD

St.  
Pt.  
Ave. No. 73

Name of Owner

Labor and Mat'l. Report

JULY 19 26

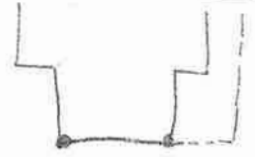

27 1/2" 29 1/2"

● Curb Box

6" Main

Elev. of  
Main at tap 5'

Gate at ●

● Gate at

● Curb Box

TAX ID # 309.27-6-3