

LABOR AND MATERIALS


1	Copper Lead	} Connection	3/4"	\$	
1	Curb			} Cock Valve T.S. & V.	} 3/4" in.
1	Service box Old returned	} Short 3 1/2 x 4 1/2 Long 4 1/2 x 5 1/2			
	Ft. 3/4" in.		} Copper C.I. C.I.	} Pipe at	\$
	Nipples	in. at			\$
	Bushings	to	in. at	\$	
	Red'g Inc'g	} Coupl'gs	to	in. at	\$
	Union				in. at
	Meter	in. at	\$		
	Compound Joints	at	\$		
	Maintenance Foreman		\$		
	Hrs. Water Maint. Man-1	at	\$		
	Hrs. Water Maint. Man-2	at	\$		
	Hrs. Garage Foreman	at	\$		
	Hrs. Labor	at	\$		
	Hrs. Compressor	at	\$		
	Trucking		\$		
	Pav't Patch		\$		
			\$		
			\$		
BROAD

St. ~~Pl.~~
Ave. No. 75

Name of Owner

Labor and Mat'l. Report JULY 1926

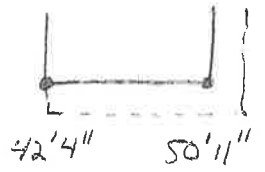

● Curb Box

6" Main

Elev. of Main at tap 5'

Gate at ● Gate at ●

● Curb Box