


# LABOR AND MATERIALS

Copper } Connection \_\_\_\_\_ \$ \_\_\_\_\_  
 Lead }  
 Curb } Cock Valve } \_\_\_\_\_ in. \$ \_\_\_\_\_  
 T.S. & V. }  
 Service box { Short 3-1/2 x 4-1/2 } \_\_\_\_\_ \$ \_\_\_\_\_  
 Old returned { Long 4-1/2 x 5-1/2 }  
 Ft. \_\_\_\_\_ in. { Copper } Pipe at \_\_\_\_\_ \$ \_\_\_\_\_  
 { G.I. }  
 { C.I. }  
 Nipples \_\_\_\_\_ in. at \_\_\_\_\_ \$ \_\_\_\_\_  
 Bushings \_\_\_\_\_ to \_\_\_\_\_ in. at \_\_\_\_\_ \$ \_\_\_\_\_  
 Red'g \_\_\_\_\_  
 Inc'g \_\_\_\_\_  
 Union \_\_\_\_\_ in. at \_\_\_\_\_ \$ \_\_\_\_\_  
 Meter \_\_\_\_\_ in. at \_\_\_\_\_ \$ \_\_\_\_\_  
 \_\_\_\_\_ \$ \_\_\_\_\_  
 Compound Joints at \_\_\_\_\_ \$ \_\_\_\_\_  
 Maintenance Foreman \_\_\_\_\_ \$ \_\_\_\_\_  
 Hrs. Water Maint. Man - 1 at \_\_\_\_\_ \$ \_\_\_\_\_  
 Hrs. Water Maint. Man - 2 at \_\_\_\_\_ \$ \_\_\_\_\_  
 Hrs. Garage Foreman \_\_\_\_\_ at \_\_\_\_\_ \$ \_\_\_\_\_  
 Hrs. Labor \_\_\_\_\_ at \_\_\_\_\_ \$ \_\_\_\_\_  
 Hrs. Compressor at \_\_\_\_\_ \$ \_\_\_\_\_  
 \_\_\_\_\_ \$ \_\_\_\_\_  
 Trucking \_\_\_\_\_ \$ \_\_\_\_\_  
 Pav't Patch \_\_\_\_\_ \$ \_\_\_\_\_  
 \_\_\_\_\_ \$ \_\_\_\_\_  
 \_\_\_\_\_ \$ \_\_\_\_\_  
 \_\_\_\_\_ \$ \_\_\_\_\_  
 \_\_\_\_\_ \$ \_\_\_\_\_


St. Broad No. 79

Name of Owner Mullen / MAYFLOWER

Labor and Mat'l. Report 19

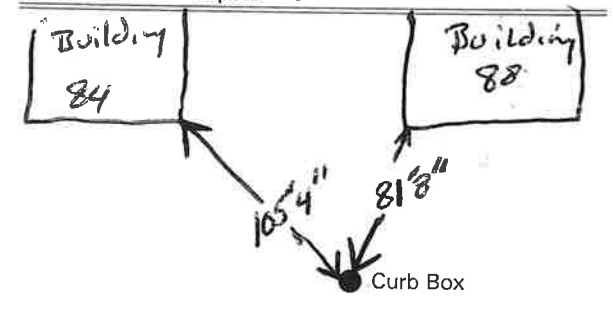

Main \_\_\_\_\_ Elev. of Main at tap \_\_\_\_\_  
 Gate at ● \_\_\_\_\_ ● Gate at \_\_\_\_\_

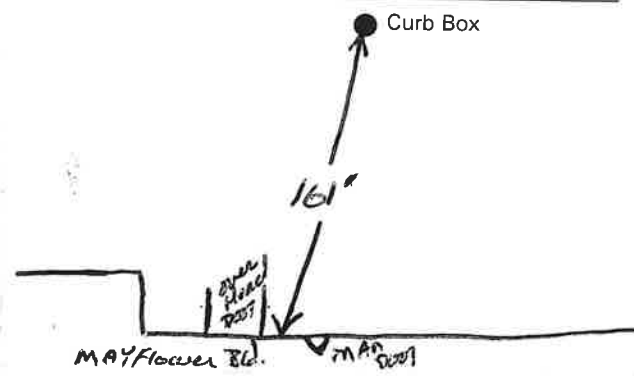

### LABOR AND MATERIALS

Copper	} Connection	_____	\$ _____
Lead			
1 Curb	} 6 in.	_____	\$ _____
		Cock	
		Valve	
	T. S. & V.		
1 Service box	} Short 3½ x 4½	_____	\$ _____
Old returned		Long 4½ x 5½	
		Buff or Rdway	
12 Ft. 6" in.	} Pipe at	_____	\$ _____
		Copper	
		G. I.	
		C. I.	
Nipples	in. at	_____	\$ _____
Bushings	to in. at	_____	\$ _____
Red'g	} Coupl'gs	_____	\$ _____
Inc'g		to in. at	
Union	in. at	_____	\$ _____
Meter	in. at	_____	\$ _____
Lead Joints	at	_____	\$ _____
Compound Joints	at	_____	\$ _____
Maintenance Foreman		_____	\$ _____
Hrs. Water Maint. Man-1	at	_____	\$ _____
Hrs. Water Maint. Man-2	at	_____	\$ _____
Hrs. Garage Foreman	at	_____	\$ _____
Hrs. Labor	at	_____	\$ _____
Hrs. Compressor	at	_____	\$ _____
Compensation Ins. at \$	per C	_____	\$ _____
Trucking		_____	\$ _____
Pav't Patch		_____	\$ _____
Tap by Lareau & Co.		_____	\$ _____
		_____	\$ _____
		_____	\$ _____
		_____	\$ _____
O'head		_____	\$ _____
		_____	\$ _____

6-21-67.

St. **REAR**  
 Pl. \_\_\_\_\_  
 Ave. No. **79**

---

*Broad*

Name of Owner  
*Mullin - Mageliner*

---

Labor and Mat'l. Report *June 21* 19 *67*

---

*6"* Main Elev. of Main at tap *5'*

Gate at ● ● Gate at

---

● Curb Box

6" Sprinkler System,  
For Building in REAR  
79 Broad St.


LABOR AND MATERIALS

1	Copper	} Connection	3/4"	\$	_____
	Lead				
1	Curb	} Cock Valve T.S. & V.	} 3/4" in.	\$	_____
1	Service box	} Short 3 1/2 x 4 1/2	} Long 4 1/2 x 5 1/2	\$	_____
	Old returned				
10	Ft.	} Copper	} 3/4" in.	\$	_____
		} Pipe at		\$	_____
	Nipples	in. at	\$	_____	
	Bushings	to in. at	\$	_____	
	Red'g	} Coupl'gs	to in. at	\$	_____
	Inc'g				
	Union	in. at	\$	_____	
	Meter	in. at	\$	_____	
			\$	_____	
	Compound Joints	at	\$	_____	
	Maintenance Foreman		\$	_____	
	Hrs. Water Maint. Man-1	at	\$	_____	
	Hrs. Water Maint. Man-2	at	\$	_____	
	Hrs. Garage Foreman	at	\$	_____	
	Hrs. Labor	at	\$	_____	
	Hrs. Compressor	at	\$	_____	
			\$	_____	
	Trucking		\$	_____	
	Pav't Patch		\$	_____	
			\$	_____	
			\$	_____	
			\$	_____	
			\$	_____	

BROAD St. REAR  
 Ave. No. 79

Name of Owner  
 MULLEN BROS. INC.

Labor and Mat'l. Report MAY 19 34

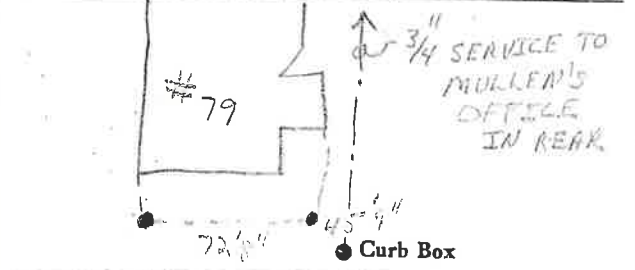

6" Main Elev. of Main at tap 5'

Gate at • Gate at •

• Curb Box