

LABOR AND MATERIALS

1	Copper Lead	} Connection	3/4"	\$	
1	Curb			} Cock Valve T.S. & V.	} 3/4" in.
1	Service box Old returned	} Short 3 1/2 x 4 1/2 Long 4 1/2 x 5 1/2			
8	Ft. 3/4 in.		} Copper G. I. C. I.	} Pipe at	\$
	Nipples	in. at			\$
	Bushings	to	in. at	\$	
	Red'g } Inc'g }	Coupl'gs	to	in. at	\$
	Union	in. at	\$		
	Meter	in. at	\$		
	Compound Joints	at	\$		
	Maintenance Foreman		\$		
	Hrs. Water Maint. Man	1 at	\$		
	Hrs. Water Maint. Man	2 at	\$		
	Hrs. Garage Foreman	at	\$		
	Hrs. Labor	at	\$		
	Hrs. Compressor	at	\$		
	Trucking		\$		
	Pav't Patch		\$		
			\$		
			\$		

BROAD

St. Pt. Ave. No. 83

Name of Owner

Labor and Mat'l. Report

AUG 19 26

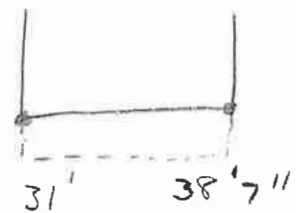

● Curb Box

6" Main

Elev. of Main at tap 6'

Gate at ●

● Gate at

● Curb Box

TAX ID # 309.27-6-1