


LABOR AND MATERIALS

1	Copper Lead	} Connection $\frac{3}{4}$ "	\$
1	Curb		} in.
		Cock Valve T.S. & V.	
1	Service box Old returned	} Short $3\frac{1}{2}$ x $4\frac{1}{2}$ Long $4\frac{1}{2}$ x $5\frac{1}{2}$	\$
8	Ft. $\frac{3}{4}$ "		} Copper G. I. C. I.
	Nipples	in. at \$	
	Bushings	to in. at \$	
	Red'g Inc'g	} Coupl'gs	to in. at \$
	Union		in. at \$
	Meter	in. at \$	
	Compound Joints	at \$	
	Maintenance Foreman	\$	
	Hrs. Water Maint. Man-1	at \$	
	Hrs. Water Maint. Man-2	at \$	
	Hrs. Garage Foreman	at \$	
	Hrs. Labor	at \$	
	Hrs. Compressor	at \$	
	Trucking	\$	
	Pav't Patch	\$	
		\$	
		\$	
BROAD St. Pl. No. 85

Name of Owner

Labor and Mat'l. Report JULY 1926

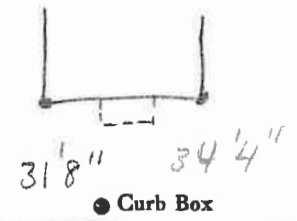

6" Main Elev. of Main at 6'

Gate at Gate at

Curb Box

TAX ID # 309.35-1-9