

LABOR AND MATERIALS

1	Copper	Connection	1 1/2"	\$	
1	Lead				
1	Curb	Cock	} 2 oriseal in.	\$	
		Valve			\$
		T.S. & V.			\$
1	Service box	Short 3 1/2 x 4 1/2	} oriseal curb box,	\$	
	Old returned	Long 4 1/2 x 5 1/2			\$
		Buff. or Rdway			\$
6	Ft. 2	Copper	} Pipe at	\$	
		C.I.			\$
		C.I.			\$
	Nipples	in. at		\$	
2	Bushings	2" Male Adaptors	to	in. at	\$
	Red'g				\$
	Inc'g	Coupl'gs	to	in. at	\$
1	Union	2" in. at	Brass Ebb		\$
	Meter	in. at			\$
	Lead Joints	at			\$
	Compound Joints	at			\$
	Maintenance Foreman				\$
	Hrs. Water Maint. Man—1	at			\$
	Hrs. Water Maint. Man—2	at			\$
	Hrs. Garage Foreman	at			\$
	Hrs. Labor—	at			\$
	Hrs. Compressor	at			\$
	Compensation Ins.	at \$		per C	\$
	Trucking				\$
	Pav't Patch				\$
	Tap by Gifford & Co.				\$
	9-24-64.				\$
	O'head				\$


Broad St.
PL
Ave. No. 9

Name of Owner

Patrick Tobacco Co.

Labor and Mat'l. Report

Sept. 24 - 1964.

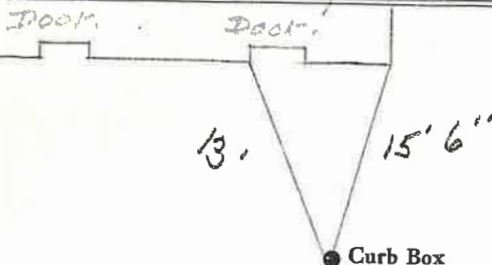

6" Main Elev. of Main at top 5'

Gate at ● Gate at ●

● Curb Box

TAX ID #309.28-1-3.1
(#9 - #15)