

LABOR AND MATERIALS

Copper } Connection	_____	\$	_____
Lead } Cock	_____		
	Valve	_____	\$
Curb } T. S. & V.	_____ in.		
	_____	\$	_____
Service box } Short 3½ x 4½	_____		
Old returned } Long 4½ x 5½	_____		
	_____	\$	_____
415' Ft. 2 in. } Copper	_____		
	<del>G.I.</del>	_____	\$
	<del>G.I.</del>	_____	\$
	_____	\$	_____
Nipples	_____ in. at	\$	_____
Bushings	_____ to _____ in. at	\$	_____
Red'g } Coupl'gs	_____ to _____ in. at	\$	_____
Inc'g }	_____	\$	_____
Union	_____ in. at	\$	_____
Meter	_____ in. at	\$	_____
	_____	\$	_____
Compound Joints	at	\$	_____
Maintenance Foreman		\$	_____
Hrs. Water Maint. Man-1	at	\$	_____
Hrs. Water Maint. Man-2	at	\$	_____
Hrs. Garage Foreman	at	\$	_____
Hrs. Labor	_____ at	\$	_____
Hrs. Compressor	at	\$	_____
	_____	\$	_____
Trucking	_____	\$	_____
Pav't Patch	_____	\$	_____
	_____	\$	_____
	_____	\$	_____

BROAD

St. Pl. Ave. No. 88

Name of Owner

Labor and Mat'l. Report

1983

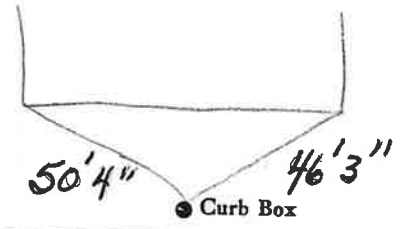

Main

Elev. of Main at tap

Gate at ●

● Gate at

41' 5" to main

● Curb Box

TAX ID # 309.35-3-5.12