

### LABOR AND MATERIALS

1	Copper Lead	Connection	3/4"		\$	
1	Curb	Cock Valve T. S. & V.	3/4" in.		\$	
1	Service box Old returned	Short 3 1/2 x 4 1/2 Long 4 1/2 x 5 1/2			\$	
11	Ft.	3/4" in.	Copper G.I. G.I.	Pipe at	\$	
	Nipples	in.	at		\$	
	Bushings	to	in.	at	\$	
	Red'g Inc'g	Coupl'gs	to	in.	\$	
	Union	in.	at		\$	
	Meter	in.	at		\$	
	Compound Joints	at			\$	
	Maintenance Foreman				\$	
	Hrs. Water Maint. Man	—1	at		\$	
	Hrs. Water Maint. Man	—2	at		\$	
	Hrs. Garage Foreman		at		\$	
	Hrs. Labor		at		\$	
	Hrs. Compressor	at			\$	
	Trucking				\$	
	Pav't Patch				\$	
					\$	
					\$	
BROAD

St.  
Pl.  
Ave. No. 89A-B

Name of Owner

Labor and Mat'l. Report

AUG 1926

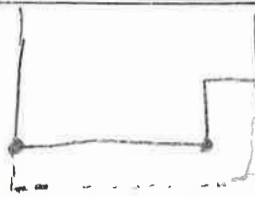

● Curb Box

6" Main

Elev. of  
Main at tap 5'

Gate at ●

● Gate at

● Curb Box

TAX ID # 309.35-1-7