


Labor and Materials

1	Copper	Lead	Connection	3/4		\$ 3.20
1	Curb	Cock Valve	T.S. & V.	3/4 in.		\$ 10.00
1	Service Box	Short 3 1/2 x 4 1/2	Long 4 1/2 x 5 1/2			\$ 1.30
	Old returned	Buff. or Rdway				
35	Ft.	3/4 in.	Copper Galv. Iron	Pipe at		\$ 7.70
	Nipples			in. at		\$
1	Bushings	3/4	to 1/2	in. at		\$.08
1	Red'g	Couplings	3/4	to 1/2	in. at	\$ 1.50
	Union			in. at		\$
	Meter			in. at		\$
	Lbs. Br. Stone	at				\$
	Lbs. Sand	at				\$
	Bags Cement	at				\$
	Paving Brick	Mack Red Asphalt	at			\$
	Lead Joints	at				\$
	Leadite Joints	at				\$
3	Hrs. Foreman	at	6 2/3			\$ 18.80
2	Hrs. Common Labor	at	5 0			\$ 1.00
10	Hrs. Common Labor	at	10 1/5			\$ 4.06
	Hrs. Mason	at				\$
	Hrs. Mason's Helper	at				\$
	Hrs. Compressor	at				\$
	Compensation Ins.					\$ 1.00
	Trucking					\$ 1.00
	Builders' Use of Water					\$
Total						\$ 21.56

Labor and Material Report

19

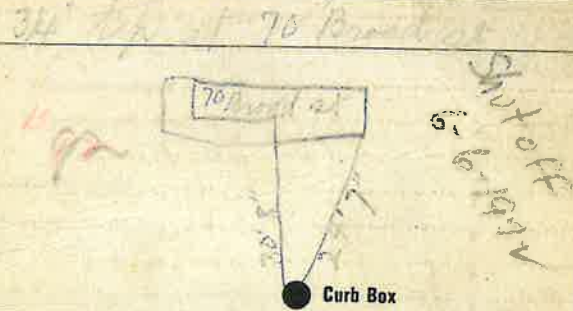

To Be Disconnected at MAIN

Main

Elev. of Main at tap

Gate at

Gate at

Curb Box

LABOR AND MATERIALS

Copper	} Connection		\$
Lead			
Curb	} Cock Valve T. S. & V. }	_____ in.	\$
Service box	} Short 3½ x 4½ } Long 4½ x 5½ }		
Old returned			\$
Ft. <u>3/4</u> in.	} Copper } } G.I. } } C.I. }	Pipe at	\$
Nipples	_____ in. at		\$
Bushings	_____ to _____ in. at		\$
Red'g } Inc'g }	Coupl'gs _____ to _____ in. at		\$
Union	_____ in. at		\$
Meter	_____ in. at		\$
			\$
Compound Joints	at		\$
Maintenance Foreman			\$
Hrs. Water Maint. Man—1	at		\$
Hrs. Water Maint. Man—2	at		\$
Hrs. Garage Foreman	at		\$
Hrs. Labor—	at		\$
Hrs. Compressor	at		\$
			\$
Trucking			\$
Pav't Patch			\$
			\$
			\$
			\$
			\$

BROAD

St. _____
Pl. _____
Ave. No. 92

Name of Owner

DR. NEVATEA - DR's OFFICE

Labor and Mat'l. Report

19 88

● Curb Box

		Elev. of
_____ Main		Main at tap _____
Gate at ●		● Gate at

● Curb Box