

LABOR AND MATERIALS

Copper	} Connection _____	\$ _____	
Lead			
Curb	} Cock Valve } _____ in.	\$ _____	
			T. S. & V.
Service box	} Short 3½ x 4½ Long 4½ x 5½ Buff or Rdway }	\$ _____	
Old returned			
11 Ft. ^{3/4} in.	} Copper G. I. } Pipe at _____	\$ _____	
Nipples	in. at _____	\$ _____	
Bushings	to _____ in. at _____	\$ _____	
Red'g	} Coupl'gs. _____ to _____ in. at _____	\$ _____	
Inc'g			
Union	in. at _____	\$ _____	
Meter	in. at _____	\$ _____	
Lead Joints	at _____	\$ _____	
Compound Joints	at _____	\$ _____	
Maintenance Foreman		\$ _____	
Hrs. Water Maint. Man-1	at _____	\$ _____	
Hrs. Water Maint. Man-2	at _____	\$ _____	
Hrs. Garage Foreman	at _____	\$ _____	
Hrs. Labor	at _____	\$ _____	
Hrs. Compressor	at _____	\$ _____	
Compensation Ins. at \$ _____	per C _____	\$ _____	
Trucking		\$ _____	
Pav't Patch		\$ _____	
<i>measured in</i>			
<i>4-17-63</i>			
<i>By Gifford & Co.</i>			
O'head		\$ _____	
		\$ _____	


Broad

St. 93
Pl. _____
Ave. No. _____

Name of Owner _____

measured in April 17

Labor and Mat'l. Report _____ 1963

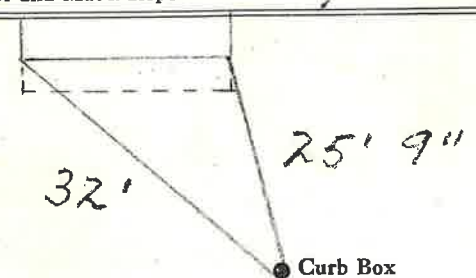

6" Main

Elev. of Main at tap 5'

Gate at •

• Gate at

• Curb Box

PIPE LINE EQUIPMENT
**JOSEPH G.
POLLARD**
CO., INC.
PIPE LINE EQUIPMENT

Place your next order with **POLLARD**

If it's from POLLARD ... It's the Best in Pipe Line Equipment

POST OFFICE: NEW HYDE PARK, NEW YORK, 11040
WAREHOUSE: ATLANTIC AND THORENS AVES., GARDEN CITY PARK, N.Y.

Branch Offices: 964 Peoples Gas Building, Chicago, Illinois
333 Candler Building, Atlanta, Georgia

PHONE: PIONEER 6-0842

