

LABOR AND MATERIALS


1	Copper	} Connection	3/4"	\$ 320
1	Lead			
1	Curb	} Cock Valve T. S. & V.	5/2 in.	\$ 100
1	Service box			
Old returned	{ Short 3 1/2 x 4 1/2 } { Long 4 1/2 x 5 1/2 } { Buff or Rdway }			\$ 140
11	Ft. 3/4" in.	} Pipe at		\$ 247
	Nipples	in. at		\$
	Bushings	to in. at		\$
	Red'g } Inc'g }	Coupl'gs	to in. at	\$
	Union	in. at		\$
	Meter	in. at		\$
	Lead Joints	at		\$
	Compound Joints	at		\$
4	Maintenance Foreman		67.5	\$ 250
	Hrs. Water Maint. Man—1	at		\$
7	Hrs. Water Maint. Man—2	at	50	\$ 350
	Hrs. Garage Foreman	at		\$
	Hrs. Labor—	at	40.78	\$ 91
	Hrs. Compressor	at		\$
	Compensation Ins. at \$	per C		\$ 19
	Trucking			\$ 100
	Pav't Patch			\$
	O'head			\$
				\$ 1602
	Patch			300
				19.02

St. 95
Pl. 73 1/2
Ave. No.

Broad

Name of Owner John Block

Labor and Mat'l. Report Aug 24 1926

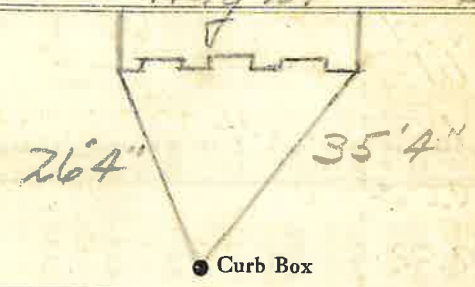

6" Main Elev. of Main at tap 6'

Gate at ● ● Gate at

● Curb Box