


LABOR AND MATERIALS

1	Copper	} Connection	3/4"	\$	
	Lead				
1	Curb	} Cock	3/4" Orisk.	\$	
					} Valve
1	Service box	} Short 3 1/2 x 4 1/2		\$	
	Old returned				} Long 4 1/2 x 5 1/2
37 Ft.	3/4 in.	} Copper		\$	
					} G. I.
	Nipples	in. at		\$	
	Bushings	to in. at		\$	
	Red'g } Inc'g }	Coupl'gs. to in. at		\$	
	Union	in. at		\$	
	Meter	in. at		\$	
	Lead Joints	at		\$	
	Compound Joints	at		\$	
	Maintenance Foreman			\$	
	Hrs. Water Maint. Man-1	at		\$	
	Hrs. Water Maint. Man-2	at		\$	
	Hrs. Garage Foreman	at		\$	
	Hrs. Labor	at		\$	
	Hrs. Compressor	at		\$	
	Compensation Ins. at \$	per C		\$	
	Trucking			\$	
	Pav't Patch			\$	
	Tap by Larsen & Co.			\$	
				\$	
				\$	
	O'head			\$	
				\$	

St. Broad
Pl. Ave. No. 102

Name of Owner **RAZED** Snyder.

Labor and Mat'l. Report Mar. 15 1967.

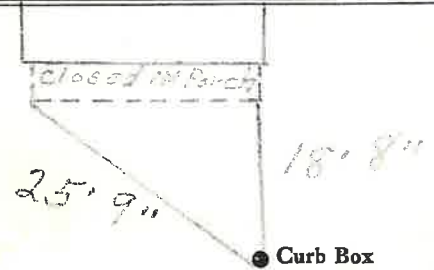

6" Main Elev. of Main at tap 5'

Gate at • Gate at

• Curb Box