

LABOR AND MATERIALS

1	Copper Lead	Connection	1"		\$ 2.47
1	Curb	Cock Valve T.S. & V.	1"	in.	\$ 3.16
1	Service Box	} Short 3" x 4" Long 4" x 5" - Buffer Rdway-			\$ 1.70
	Old returned				
10 Ft.	1"	Copper Galv Iron Cast Iron		Pipe at	24 \$ 2.40
	Nipples			in. at	\$
	Bushings			to in. at	\$
	Red'g Inc'g	Couplings		to in. at	\$
	Union			in. at	\$
	Meter			in. at	\$
	Lead Joints			at	\$
	Leadite Joints			at	\$
	Hrs. Foreman			at	\$
3	Hrs. Chauffeur			at	\$ 1.78
8	Hrs. Tapper			at	\$ 5.02
17	Hrs. Labor			at	\$ 7.65
	Hrs. Labor			at	\$
4	Hrs. Compressor			at	\$ 2.50
	Compensation Ins.				\$.45
	Trucking				\$ 1.00
	Builders Use of Water	1/2 Patch (Sewer)			\$ 2.50
	<i>apply Messal</i>				\$
					\$
					\$
					\$
					\$ 30.71

1 0 1941

B 17-21
St. *17*
Pl. *11-13*
Ave. No.

Brook


Name of Owner

Ashley BRAY Oil Co

Labor and Mat'l. Report

Apr 15 1941

BLD. RAZED 1998

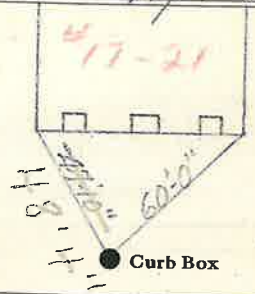

6 Main

Elev. of Main at tap *5*

Gate at ●

● Gate at

● Curb Box