

76-64

#113

Labor and Material Report

Jan 1994 19

89 Broad St



Main

Elev. of Main at tap

5

Gate at

Gate at

Curb Box


76-64

#113

Labor and Material Report

Jan 1994 19

89 Broad St

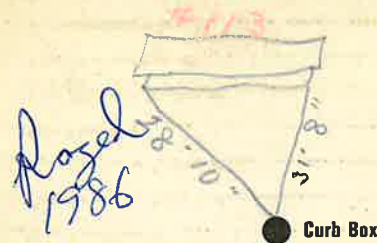

Main

Elev. of Main at tap

5

Gate at

Gate at

Curb Box

004