

LABOR AND MATERIALS

1 Copper } Connection 3/4" \$  
~~1~~ }  
 1 Curb } Cock } 3/4 in. ORISEAL \$  
           } Valve }  
           } ~~Pressure~~ }  
 1 Service box { Short  $3\frac{1}{2} \times 4\frac{1}{2}$  }  
 Old returned { Long  $4\frac{1}{2} \times 5\frac{1}{2}$  } \$  
                   { Buff or Rdway }  
13'-5" Ft. 3/4 in. { Copper } Pipe at \$  
                                   { C.I. }  
                                   { C.I. }  
 \_\_\_\_\_ Nipples \_\_\_\_\_ in. at \$  
 \_\_\_\_\_ Bushings \_\_\_\_\_ to \_\_\_\_\_ in. at \$  
 Red'g }  
 Inc'g } Coupl'gs \_\_\_\_\_ to \_\_\_\_\_ in. at \$  
 \_\_\_\_\_ Union \_\_\_\_\_ in. at \$  
 \_\_\_\_\_ Meter \_\_\_\_\_ in. at \$  
 \_\_\_\_\_ Lead Joints at \$  
 \_\_\_\_\_ Compound Joints at \$  
 \_\_\_\_\_ Maintenance Foreman \$  
 \_\_\_\_\_ Hrs. Water Maint. Man-1 at \$  
 \_\_\_\_\_ Hrs. Water Maint. Man-2 at \$  
 \_\_\_\_\_ Hrs. Garage Foreman \_\_\_\_\_ at \$  
 \_\_\_\_\_ Hrs. Labor \_\_\_\_\_ at \$  
 \_\_\_\_\_ Hrs. Compressor at \$  
 \_\_\_\_\_ Compensation Ins. at \$ \_\_\_\_\_ per C \$  
 \_\_\_\_\_ Trucking \$  
 \_\_\_\_\_ Pav't Patch \$  
Tap By Paris Co \$  
Aug-17-1976 \$  
 \_\_\_\_\_ O'head \$  
 \_\_\_\_\_ \$

BROAD

St. REAR  
 Pt.  
 Ave. No. 115


Name of Owner

LEONA RAYMOND

Labor and Mat'l. Report

Aug 17

1976

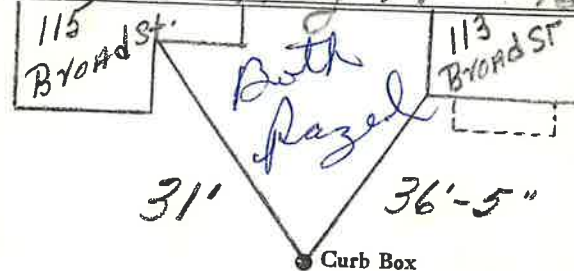

6" Main

Elev. of  
 Main at tap 5'

Gate at ●

● Gate at

● Curb Box