


LABOR AND MATERIALS

Copper } Connection _____	\$ _____
Lead } _____	\$ _____
Curb } Cock Valve } _____ in.	\$ _____
} T. S. & V. }	\$ _____
Service box } Short 3 1/2 x 4 1/2 }	\$ _____
Old returned } Long 4 1/2 x 5 1/2 }	
} Buff or Rdway }	
Ft. _____ in. } Copper } Pipe at _____	\$ _____
} G. I. }	
} C. I. }	
Nipples _____ in. at _____	\$ _____
Bushings _____ to _____ in. at _____	\$ _____
Red'g } Coupl'gs _____ to _____ in. at _____	\$ _____
Inc'g }	
Union _____ in. at _____	\$ _____
Meter _____ in. at _____	\$ _____
Lead Joints at _____	\$ _____
Compound Joints at _____	\$ _____
Maintenance Foreman _____	\$ _____
Hrs. Water Maint. Man-1 at _____	\$ _____
Hrs. Water Maint. Man-2 at _____	\$ _____
Hrs. Garage Foreman _____ at _____	\$ _____
Hrs. Labor- _____ at _____	\$ _____
Hrs. Compressor at _____	\$ _____
Compensation Ins. at \$ _____ per C _____	\$ _____
Trucking _____	\$ _____
Pav't Patch _____	\$ _____
_____	\$ _____
_____	\$ _____
_____	\$ _____
O'head _____	\$ _____
_____	\$ _____


Little Ceasar's Pizza  
NEW PIZZA PLACE

Broad & Hudson St. 116  
Ave. No. 116

Name of Owner Broad

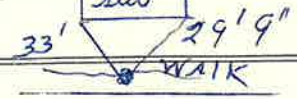

Labor and Mat'l. Report JUNE 19 84

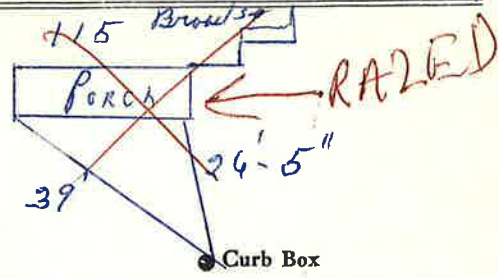

Main \_\_\_\_\_ Elev. of Main at tap \_\_\_\_\_  
Gate at • \_\_\_\_\_ • Gate at \_\_\_\_\_

• Curb Box  
42' 5 inches  
of Copper