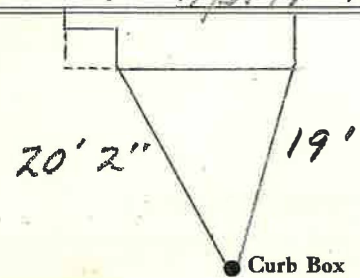


LABOR AND MATERIALS

1 Copper } Connection $\frac{3}{4}$ " \$ _____
 1 Lead } }
 1 Curb } Cock } $\frac{3}{4}$ in. \$ _____
 } Valve } }
 } T.S. & V. } }
 1 Service box } Short $3\frac{1}{2} \times 4\frac{1}{2}$ } \$ _____
 Old returned } Long $4\frac{1}{2} \times 5\frac{1}{2}$ } }
 } Buff or Rdway } }
 41 Ft. $\frac{3}{4}$ in. } Copper } Pipe at \$ _____
 } G.I. } }
 } G.I. } }
 Nipples in. at \$ _____
 Bushings to in. at \$ _____
 Red'g } Coupl'gs to in. at \$ _____
 Inc'g } }
 Union in. at \$ _____
 Meter in. at \$ _____
 Lead Joints at \$ _____
 Compound Joints at \$ _____
 Maintenance Foreman \$ _____
 Hrs. Water Maint. Man-1 at \$ _____
 Hrs. Water Maint. Man-2 at \$ _____
 Hrs. Garage Foreman at \$ _____
 Hrs. Labor at \$ _____
 Hrs. Compressor at \$ _____
 Compensation Ins. at \$ _____ per C. \$ _____
 Trucking \$ _____
 Pav't Patch \$ _____
 Tap by Giggard & Co. \$ _____
 4-15-59. \$ _____
 O'head \$ _____
 \$ _____

✓
 Broad St. Ave. No. 22
 Name of Owner De Angelo
 Labor and Mat'l. Report April 15 1959

 6 Main Elev. of Main at tap $5\frac{1}{2}$ '
 Gate at • Gate at •
 • Curb Box
 TAX ID # 309.28-5-5
 LSM-5C-2-5 58