

LABOR AND MATERIALS


1	Copper Lead	Connection	3/4"	\$	2.71
1	Curb	Cock Valve T.S. & V.	3/4 in.	\$	3.83
1	Service box	Short 3 1/2 x 4 1/2		\$	4.69
	Old returned	Long 4 1/2 x 5 1/2		\$	
		Buff or Rdway		\$	
11	Ft. 3/4 in.	Copper C.I. C.I.	Pipe at 45	\$	4.95
	Nipples	in. at		\$	
	Bushings	to in. at		\$	
	Red'g Inc'g	Coupl'gs to in. at		\$	
	Union	in. at		\$	
	Meter	in. at		\$	
	Lead Joints	at		\$	
	Compound Joints	at		\$	
	Maintenance Foreman			\$	8.16
	Hrs. Water Maint. Man-1	at		\$	
	Hrs. Water Maint. Man-2	at		\$	
333	Hrs. Garage Foreman	at 1.59		\$	4.77
	Hrs. Labor	at 1.13		\$	3.39
	Hrs. Compressor	at		\$	
	Compensation Ins.	at \$4.29 per C.		\$	3.5
	Trucking			\$	1.50
	Pav't Patch			\$	13.50
	Tap by Wadleigh + Ware			\$	
		11-17-55		\$	
	O'head			\$	
				\$	39.16

26.19

St. Broad  
-Pl-  
Ave. No. 121

Name of Owner  
Barkowitz

Labor and Mat'l. Report Nov. 17 19 55

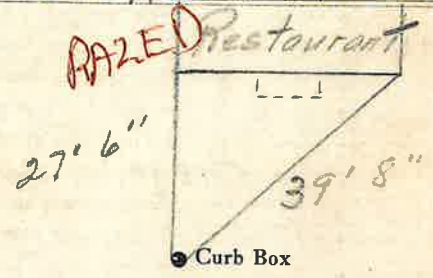

6" Main Elev. of Main at tap 5 1/2'

Gate at • Gate at

• Curb Box