

LABOR AND MATERIALS

1	Copper Lead	{ Connection	3/4	\$ 1.23
1	Curb	{ Cock Valve	3/4 in.	\$ 1.68
1	Service Box Old returned	{ Short 3 1/2 x 4 1/2 Long 4 1/2 x 5 1/2 Buff. or Rdway		\$ 1.54
20 Ft.	3/4 in.	{ Copper Galv Iron Cast Iron	Pipe at 17	\$ 3.40
	Nipples	in. at		\$
	Bushings	to in. at		\$
	Red'g Inc'g	{ Couplings	to in. at	\$
	Union	in. at		\$
	Meter	in. at		\$
	Lead Joints	at		\$
	Leadite Joints	at		\$
	Hrs. Foreman	at		\$
4	Hrs. Chauffeur	at 6 1/2 hr		\$ 2.50
8	Hrs. Tapper	at 7		\$ 5.00
8	Hrs. Labor	at 4 1/2		\$ 3.60
	Hrs. Labor	at		\$
	Hrs. Compressor	at		\$
	Compensation Ins.			\$ 34
	Trucking			\$ 1-
	Builders Use of Water	Patch		\$ 5-
	Tap by Russell			\$
				\$
				\$
				\$
				\$ 25.29

5 2 - - 1939

St. #121 R
Pt.
Ave. No. 99 1/2

Broad


Name of Owner

Berkowitz

Labor and Mat'l. Report

Aug 3

1939

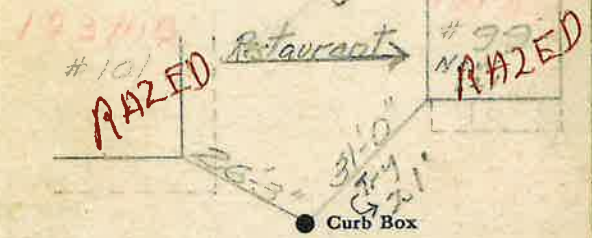

6 Main

Elev. of Main at tap 5-

Gate at ●

● Gate at

● Curb Box

did shut off