


Labor and Materials

Lead Connection	3	\$	2.69
Curb Cock	1	\$	1.76
Service Box	(Sheet 3 x 4)		
Old returned	Long 4 1/2 x 5 1/2	\$	
	Buffalo		
9 Ft. 1/2 in. G. I. Pipe at		\$	1.76
Nipples	in. at	\$	
Bushings	to in. at	\$	
Red'g Coup	to in. at	\$	
Inc'g Coup	to in. at	\$	
Union	in. at	\$	
Meter	in. at	\$	
Cu. Yds. Br. Stone at		\$	
Cu. Yds. Sand at		\$	
Bags Cement at		\$	
Paving Brick	{ Mack Red Asphalt }	at	\$
3 Hrs. Foreman at		\$	1.89
6 Hrs. Common Labor at		\$	2.44
Hrs. Mason at		\$	
Hrs.	at	\$	
Hrs.	at	\$	
Builders' Use of Water		\$	
Count Ins		at	\$ 1.11
Intake		at	\$ 1.00
		at	\$
		at	\$
Total		\$	11.64

123 A Oct 10 19 Labor and Material Report

101 ~~Board~~ St ✓

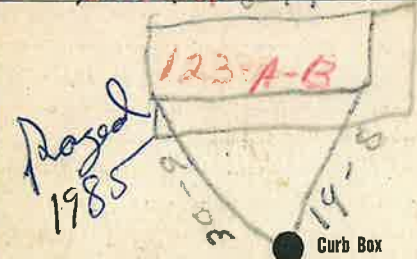

6 Main Elev. of Main at tap 1.2
Gate at ● Gate at ●

● Curb Box
old top to be dug up.