

## LABOR AND MATERIALS

Copper	} Connection _____	_____	\$ _____	
Lead				
Curb	} Cock	_____ in.	\$ _____	
				} Valve
Service box	} Short 3½ x 4½	_____	\$ _____	
Old returned				Long 4½ x 5½
				Buff or Rdway
49 Ft. 2 in.	} Copper	_____	\$ _____	
_____				G.I.
				_____
Nipples	_____ in. at _____	\$ _____		
Bushings	_____ to _____ in. at _____	\$ _____		
Red'g	} Coupl'gs _____ to _____ in. at _____	\$ _____		
Inc'g				
Union	_____ in. at _____	\$ _____		
Meter	_____ in. at _____	\$ _____		
Lead Joints	_____ at _____	\$ _____		
Compound Joints	_____ at _____	\$ _____		
Maintenance Foreman	_____ at _____	\$ _____		
Hrs. Water Maint. Man-1	_____ at _____	\$ _____		
Hrs. Water Maint. Man-2	_____ at _____	\$ _____		
Hrs. Garage Foreman	_____ at _____	\$ _____		
Hrs. Labor	_____ at _____	\$ _____		
Hrs. Compressor	_____ at _____	\$ _____		
Compensation Ins. at \$ _____	per C _____	\$ _____		
Trucking	_____	\$ _____		
Pav't Patch	_____	\$ _____		
_____	_____	\$ _____		
_____	_____	\$ _____		
O'head	_____	\$ _____		
_____	_____	\$ _____		


130 BROAD

St.  
Pl.  
Ave. No. 130

Name of Owner \_\_\_\_\_

Labor and Mat'l. Report \_\_\_\_\_

Dec 19 87

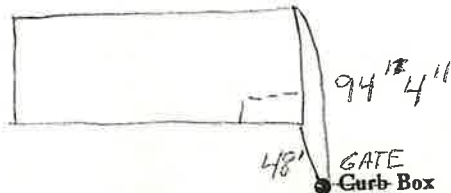

\_\_\_\_\_ Main

Elev. of  
Main at tap \_\_\_\_\_

Gate at ●

● Gate at

● Curb Box