

LABOR AND MATERIALS

1	Copper Lead	} Connection	$3/4''$		\$
1	Curb	} Cock Valve T. S. & V.	$3/4''$ in.		\$
1	Service box Old returned	} Short $3\frac{1}{2} \times 4\frac{1}{2}$ Long $4\frac{1}{2} \times 5\frac{1}{2}$			\$
37	Ft. $3/4$ in.	} Copper Pipe		Pipe at	\$
	Nipples	in. at			\$
	Bushings	to in. at			\$
	Red'g Inc'g	} Coupl'gs	to in. at		\$
	Union	in. at			\$
	Meter	in. at			\$
	Compound Joints	at			\$
	Maintenance Foreman				\$
	Hrs. Water Maint. Man-1	at			\$
	Hrs. Water Maint. Man-2	at			\$
	Hrs. Garage Foreman	at			\$
	Hrs. Labor	at			\$
	Hrs. Compressor	at			\$
	Trucking				\$
	Pav't Patch				\$
					\$
					\$

BROAD

St.
Pl.
Ave. No. 138

Name of Owner

Labor and Mat'l. Report

JUNE 19 34

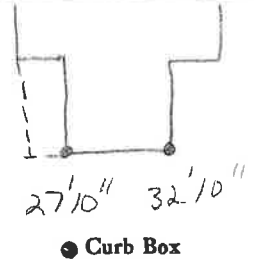

6''

Elev. of
Main at tap $4\frac{1}{2}'$

Gate at ●

● Gate at

● Curb Box