

LABOR AND MATERIALS

1	Copper	Connection	3/4"	\$	2.76
1	Curb	Valve	3/4 in.	\$	3.49
1	Service box	Short 3 1/2 X 4 1/2		\$	4.74
	Old returned	Long 4 1/2 X 5 1/2		\$	
		Buffer Rdway		\$	
9	Ft.	Copper	Pipe at 38	\$	3.42
		G. I.		\$	
		C. I.		\$	
	Nipples	in. at		\$	
	Bushings	to in. at		\$	
	Red'g			\$	
	Inc'g	Coupl'gs to in. at		\$	
	Union	in. at		\$	
	Meter	in. at		\$	
	Lead Joints	at		\$	
	Compound Joints	at		\$	
	Hrs. Water Maint. Man-1	at		\$	
9	Hrs. Water Maint. Man-2	at 1.24		\$	11.16
22	Hrs. Labor	at 1.13		\$	24.86
	Hrs. Labor	at		\$	
	Hrs. Compressor	at		\$	
	Compensation Ins.	at \$ 4.406 per C		\$	1.59
	Trucking			\$	1.00
	Pay't Patch			\$	10.80
	O'head	53.00		\$	
				\$	63.82

used same box
put in 4-23-53


43.53

Broad

St. Ave. No. 23

Name of Owner
Del Signore

Labor and Mat'l. Report June 16 1953

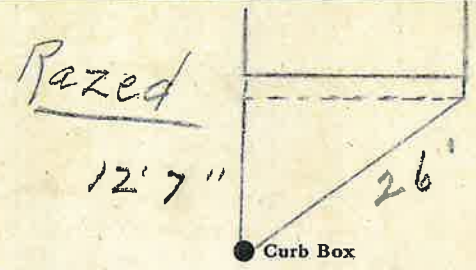

6" Main Elev. of Main at tap 5 1/2'

Gate at ● Gate at ●

● Curb Box
shut off at curb
BOX.