


LABOR AND MATERIALS

COPPER
 Copper } Connection *X 3/4* \$ _____
 Lead }
3/4 Curb } Cock Valve } *3/4* in. \$ _____
 } T.S. & V. }
3/4 Service box } Short *3 1/2* x *4 1/2* }
 Old returned } Long *4 1/2* x *5 1/2* } \$ _____
30 Ft. *3/4* in. } Copper } Pipe at \$ _____
 } G. I. }
 } C.I. }
 Nipples in. at \$ _____
 Bushings to in. at \$ _____
 Red'g }
 Inc'g } Coupl'gs to in. at \$ _____
 Union in. at \$ _____
 Meter in. at \$ _____
 \$ _____
 Compound Joints at \$ _____
 Maintenance Foreman \$ _____
 Hrs. Water Maint. Man-1 at \$ _____
 Hrs. Water Maint. Man-2 at \$ _____
 Hrs. Garage Foreman at \$ _____
 Hrs. Labor at \$ _____
 Hrs. Compressor at \$ _____
 \$ _____
 Trucking \$ _____
 Pav't Patch \$ _____
 \$ _____
 \$ _____
BROAD St. _____
 Pt. _____
 Ave. No. *142*

Name of Owner _____

5/14/07
 Labor and Mat'l. Report ~~JULY 19~~

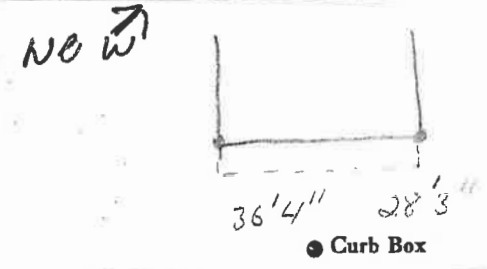

6" Main Elev. of Main at tap *6'*
 Gate at ● Gate at

TAX ID # 309.7-14-8

5/14/07 ● Curb Box
NEW TAP AND SERVICE

old OFF AT MAIN 5/14/07