


### Labor and Materials

|       |   |          |    |
|-------|---|----------|----|
| 1     | Lead Connection <sup>3/4</sup>  | .....    | \$ |
|       | Curb Cock   | .....    | \$ |
| 1     | Service Box { Short 3 1/2 x 4 1/2<br>Old returned { Long 4 1/2 x 5 1/2<br>Buffalo | .....    | \$ |
| 8     | Ft. in. G. I. Pipe at   | .....    | \$ |
|       | Nipples in. at  | .....    | \$ |
|       | Bushings to in. at  | .....    | \$ |
|       | Red'g Coup to in. at  | .....    | \$ |
|       | Inc'g Coup to in. at  | .....    | \$ |
|       | Union in. at  | .....    | \$ |
|       | Meter in. at  | .....    | \$ |
|       | Cu. Yds. Br. Stone at   | .....    | \$ |
|       | Cu. Yds. Sand at  | .....    | \$ |
|       | Bags Cement at  | .....    | \$ |
|       | Paving Brick { Mack<br>Red<br>Asphalt } at  | .....    | \$ |
| 2 1/2 | Hrs. Foreman at   | .....    | \$ |
| 2 1/2 | Hrs. Common Labor at  | .....    | \$ |
|       | Hrs. Mason at   | .....    | \$ |
|       | Hrs. at   | .....    | \$ |
|       | Hrs. at   | .....    | \$ |
|       | Builders' Use of Water  | .....    | \$ |
|       | at  | .....    | \$ |
|       | at  | .....    | \$ |
|       | at  | .....    | \$ |
|       | at  | .....    | \$ |
|       | Total   | \$ 10.62 |    |

### Labor and Material Report 0018 19

3/4" tap at 119 west at

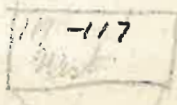

143A 4

35' 5"

33' 6"

● Curb Box

Main

Elev. of Main at tap

Gate at ●

TAX ID # 309.7-12-33

● Gate at

● Curb Box

SHUT OFF @ curb -10-25-99  
RAZED